


1 LOCATION OF WATER WELL: Fraction NW 1/4 SW 1/4 SW 1/4 Section Number 1 Township Number T 8 S Range Number R 11 EW
 County: POTTAWATOMIE

Distance and direction from nearest town or city street address of well if located within city?
 3/4 north, 4 1/2 west of St. Clere

2 WATER WELL OWNER: Dan Oaks
 RR#, St. Address, Box #: Rt. 1 Box 46 Board of Agriculture, Division of Water Resources
 City, State, ZIP Code: Onaga, KS 66521 Application Number:

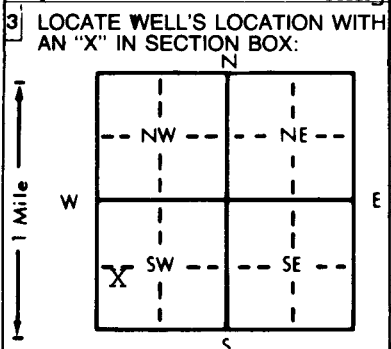

4 DEPTH OF COMPLETED WELL: 100' ft. ELEVATION:
 Depth(s) Groundwater Encountered 1. 90' ft. 2. ft. 3. ft.
 WELL'S STATIC WATER LEVEL: 37' ft. below land surface measured on mo/day/yr 5-12-93
 Pump test data: Well water was ft. after hours pumping gpm
 Est. Yield: 40 gpm: Well water was ft. after hours pumping gpm
 Bore Hole Diameter: 8 3/4 in. to ft., and in. to ft.
 WELL WATER TO BE USED AS:
 1 Domestic 3 Feedlot 6 Oil field water supply 9 Dewatering 12 Other (Specify below)
 2 Irrigation 4 Industrial 7 Lawn and garden only 10 Monitoring well
 Was a chemical/bacteriological sample submitted to Department? Yes No X; If yes, mo/day/yr sample was submitted Water Well Disinfected? Yes X No

5 TYPE OF BLANK CASING USED:
 1 Steel 3 RMP (SR) 5 Wrought iron 8 Concrete tile CASING JOINTS: Glued X Clamped
 2 PVC 4 ABS 6 Asbestos-Cement 9 Other (specify below) Welded
 7 Fiberglass Threaded
 Blank casing diameter 5" in. to 0-60 ft., Dia in. to ft., Dia in. to ft.
 Casing height above land surface 24" in., weight 2.82 lbs./ft. Wall thickness or gauge No. 258
 TYPE OF SCREEN OR PERFORATION MATERIAL:
 1 Steel 3 Stainless steel 5 Fiberglass 7 PVC 10 Asbestos-cement
 2 Brass 4 Galvanized steel 6 Concrete tile 8 RMP (SR) 11 Other (specify)
 9 ABS 12 None used (open hole)
 SCREEN OR PERFORATION OPENINGS ARE:
 1 Continuous slot 3 Mill slot 5 Gauzed wrapped 8 Saw cut 11 None (open hole)
 2 Louvered shutter 4 Key punched 6 Wire wrapped 9 Drilled holes
 7 Torch cut 10 Other (specify)
 SCREEN-PERFORATED INTERVALS: From 60 ft. to 100 ft., From ft. to ft.
 GRAVEL PACK INTERVALS: From 24 ft. to 100 ft., From ft. to ft.

6 GROUT MATERIAL: 1 Neat cement 2 Cement grout 3 Bentonite 4 Other
 Grout Intervals: From 4 ft. to 24 ft., From ft. to ft.
 What is the nearest source of possible contamination:
 1 Septic tank 4 Lateral lines 7 Pit privy 10 Livestock pens 14 Abandoned water well
 2 Sewer lines 5 Cess pool 8 Sewage lagoon 11 Fuel storage 15 Oil well/Gas well
 3 Watertight sewer lines 6 Seepage pit 9 Feedyard 12 Fertilizer storage 16 Other (specify below)
 13 Insecticide storage
 Direction from well? west How many feet? 325'

FROM	TO	LITHOLOGIC LOG	FROM	TO	PLUGGING INTERVALS
0	1	Clay-Brown	46	50	Shale-Yellow
1	2	Limestone-Yellow	50	55	Limestone-Yellow
2	4	Shale-Yellow	55	58	Shale-Black
4	10	Shaley Limestone-Yellow	58	59	Limestone-Grey
10	15	Limestone-Yellow	59	61	Limestone-Yellow
15	16	Shale-Yellow	61	65	Shale-Grey
16	21	Limestone-Yellow	65	66	Limestone-Yellow
21	24	Shale-Grey	66	72	Shale-Yellow
24	25	Shale-Yellow	72	80	Limestone-Yellow
25	26	Limestone-Yellow	80	85	Shale-Yellow
26	34	Shale-Yellow	85	90	Limestone-Yellow-Loose
34	40	Shale-Red	90	95	Limestone-Grey
40	42	Shale-Yellow	95	100	Shale-Grey
42	44	Shale-Red			
44	46	Limestone-Yellow			

7 CONTRACTOR'S OR LANDOWNER'S CERTIFICATION: This water well was (1) constructed, (2) reconstructed, or (3) plugged under my jurisdiction and was completed on (mo/day/year) 5-12-93 and this record is true to the best of my knowledge and belief. Kansas Water Well Contractor's License No. 182 This Water Well Record was completed on (mo/day/yr) 5-12-93 under the business name of STRADER DRILLING CO., INC. by (signature) Dale Strader