


1 LOCATION OF WATER WELL: Fraction N.E. 1/4 N.E. 1/4 S.E. 1/4 Section Number 31 Township Number T 8 S Range Number R 11 ~~EW~~  
 County: Pott.

Distance and direction from nearest town or city street address of well if located within city? 6.25 miles north of U.S. 24 on Onaga Rd. .5 mile east and 600' north

2 WATER WELL OWNER: Robert L. Massion  
 RR#, St. Address, Box # : RT. 2 Bx. 322 Board of Agriculture, Division of Water Resources  
 City, State, ZIP Code : Wamego Ks. 66547 Application Number:

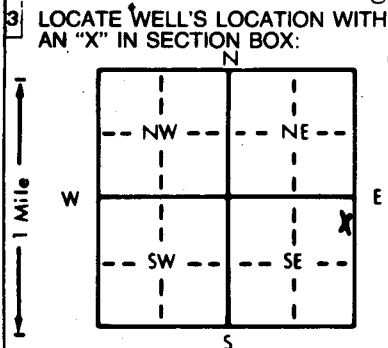

4 DEPTH OF COMPLETED WELL... 50 ft. ELEVATION: .....  
 Depth(s) Groundwater Encountered 1. 18' 6" ft. 2. .... ft. 3. .... ft.  
 WELL'S STATIC WATER LEVEL 18' 6" ft. below land surface measured on mo/day/yr 10-25-91  
 Pump test data: Well water was 46 ft. after 1 hours pumping 125 gpm  
 Est. Yield 125 gpm: Well water was 49 ft. after 2 hours pumping 150 gpm  
 Bore Hole Diameter 32 in. to 50 ft., and ..... in. to ..... ft.  
 WELL WATER TO BE USED AS: 5 Public water supply 8 Air conditioning 11 Injection well  
 1 Domestic 3 Feedlot 6 Oil field water supply 9 Dewatering 12 Other (Specify below)  
 2 Irrigation 4 Industrial 7 Lawn and garden only 10 Monitoring well .....  
 Was a chemical/bacteriological sample submitted to Department? Yes.....No...~~XX~~...; If yes, mo/day/yr sample was submitted  
 Water Well Disinfected? Yes ~~XX~~ No

5 TYPE OF BLANK CASING USED: 5 Wrought iron 8 Concrete tile CASING JOINTS: Glued ~~XX~~ Clamped .....  
 1 Steel 3 RMP (SR) 6 Asbestos-Cement 9 Other (specify below) Welded .....  
 - 2 PVC 4 ABS 7 Fiberglass ..... Threaded.....  
 Blank casing diameter 16 in. to 30 ft., Dia ..... in. to ..... ft., Dia ..... in. to ..... ft.  
 Casing height above land surface 36 in., weight ..... lbs./ft. Wall thickness or gauge No. ....  
 TYPE OF SCREEN OR PERFORATION MATERIAL: 7 PVC 10 Asbestos-cement  
 1 Steel 3 Stainless steel 5 Fiberglass 8 RMP (SR) 11 Other (specify) .....  
 2 Brass 4 Galvanized steel 6 Concrete tile 9 ABS 12 None used (open hole)  
 SCREEN OR PERFORATION OPENINGS ARE: 5 Gauzed wrapped 8 Saw cut 11 None (open hole)  
 1 Continuous slot 3 Mill slot 6 Wire wrapped 9 Drilled holes  
 2 Louvered shutter 4 Key punched 7 Torch cut 10 Other (specify) .....  
 SCREEN-PERFORATED INTERVALS: From 30 ft. to 50 ft., From ..... ft. to ..... ft.  
 From ..... ft. to ..... ft., From ..... ft. to ..... ft.  
 GRAVEL PACK INTERVALS: From 18 ft. to 50 ft., From ..... ft. to ..... ft.  
 From ..... ft. to ..... ft., From ..... ft. to ..... ft.

6 GROUT MATERIAL: 1 Neat cement 2 Cement grout 3 Bentonite 4 Other .....  
 Grout intervals: From 0 ft. to 18 ft., From ..... ft. to ..... ft., From ..... ft. to ..... ft.  
 What is the nearest source of possible contamination:  
 1 Septic tank 4 Lateral lines 7 Pit privy 10 Livestock pens 14 Abandoned water well  
 2 Sewer lines 5 Cess pool 8 Sewage lagoon 11 Fuel storage 15 Oil well/Gas well  
 3 Watertight sewer lines 6 Seepage pit 9 Feedyard 12 Fertilizer storage 16 Other (specify below)  
 13 Insecticide storage ..... road ditch.....  
 Direction from well? east How many feet? 50

FROM	TO	LITHOLOGIC LOG	FROM	TO	PLUGGING INTERVALS
0	3	Black silty clay			
3	34	Grey and brown clays			
34	35	Small grey gravel and grey clay			
35	36	Small grey gravel			
36	41	Medium-large grey gravel			
41	49	Medium-large grey gravel and grey clay			
49	50	Large cobbles, stopped			

7 CONTRACTOR'S OR LANDOWNER'S CERTIFICATION: This water well was (4) constructed, (2) reconstructed, or (3) plugged under my jurisdiction and was completed on (mo/day/year) 10-22-91 and this record is true to the best of my knowledge and belief. Kansas Water Well Contractor's License No. 323 This Water Well Record was completed on (mo/day/yr) 11-4-91 under the business name of Hoobler Drilling Co, by (signature)

INSTRUCTIONS: Use typewriter or ball point pen. PLEASE PRESS FIRMLY and PRINT clearly. Please fill in blanks, underline or circle the correct answers. Send top three copies to Kansas Department of Health and Environment, Bureau of Water, Topeka, Kansas 66620-0001. Telephone: 913-296-5545. Send one to WATER WELL OWNER and retain one for your records.