

35


USE TYPEWRITER OR BALL POINT PEN-PRESS FIRMLY, PRINT CLEARLY.

WATER WELL RECORD
KSA 82a-1201-1215

Kansas Department of Health and Environment-Division of Environment
(Water well Contractors)
Topeka, Kansas 66620

1. Location of well: County JACKSON Fraction SW NW NE Section number 36 Township number T 8 S R 12 Range number EW

2. Distance and direction from nearest town or city: 2 E 1 N
Street address of well location if in city: OF EMMETT
3. Owner of well: MRS. R. VANBUREN VOLD
R.R. or street: _____
City, state, zip code: EMMETT, KS.

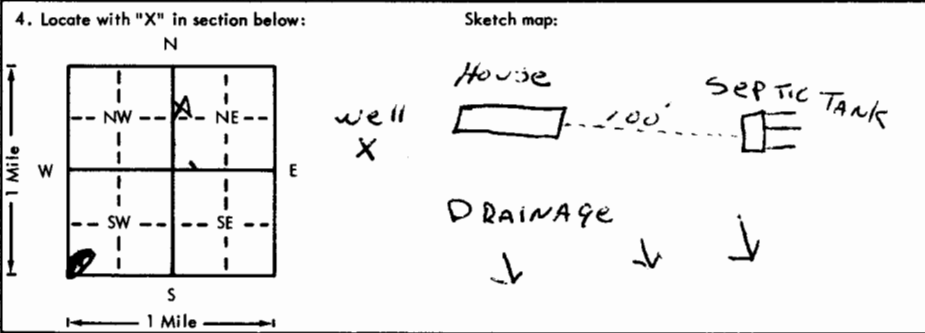

6. Bore hole dia. 10 in. Completion date _____
Well depth 70 ft. 3-22-76

7. Cable tool Rotary Driven Dug
 Hollow rod Jetted Bored Reverse rotary

8. Use: Domestic Public supply Industry
 Irrigation Air conditioning Stock
 Lawn Oil field water Other

9. Casing: Material PVC Height: Above or below
Threaded _____ Welded _____ Surface 24 in.
RMP _____ PVC 9L Weight 2.58 lbs./ft. 2.74 MNC
Dia. 5 in. to 70 ft. depth; Wall Thickness: inches or
Dia. _____ in. to _____ ft. depth; gage No. 2.58

5. Type and color of material	From	To
TOP SOIL	0	2
Brown Clay	2	10
Gray shale	10	25
Gray Lime	25	37
Blue shale	37	55
Yellow Lime	55	59
Red shale	59	70
(Use a second sheet if needed)		

10. Screen: Manufacturer's name _____
Ruapco
Type PVC Dia. 5"
Slot/gauze 0.60 Length 25'
Set between _____ ft. and _____ ft.
37 ft. and 62 ft.
Gravel pack? Size range of material 1/4 X 1/8

11. Static water level: _____ mo./day/yr.
37 ft. below land surface Date 3-22-76

12. Pumping level below land surfaces: AIR TEST
_____ ft. after _____ hrs. pumping _____ g.p.m.
_____ ft. after _____ hrs. pumping _____ g.p.m.
Estimated maximum yield _____ g.p.m.

13. Water sample submitted: _____ mo./day/yr.
Yes No Date _____

14. Well head completion: CAPPED
 Pitless adapter 24 inches above grade

15. Well grouted?
With: Neat cement Bentonite Concrete
Depth: From 0 ft. to 10 ft.

16. Nearest source of possible contamination: _____
ft. 150 Direction E Type SEPTIC TANK
Well disinfected upon completion? Yes No

17. Pump: Not installed
Manufacturer's name _____
Model number _____ HP _____ Volts _____
Length of drop pipe _____ ft. capacity _____ g.p.m.
Type:
 Submersible Turbine
 Jet Reciprocating
 Centrifugal Other

18. Elevation: 1028
Topography: fl m
 Hill OK
 Slope
 Upland
 Valley

19. Remarks: OWNER WILL INSTALL SLOP

20. Water well contractor's certification:
This well was drilled under my jurisdiction and this report is true to the best of my knowledge and belief.
Strater Drilling Co Inc 182
Business name _____ License No. _____
Address RT 1 Holton, KS
Signed Dale Robinson Date 3-22-76
Authorized representative

2.74 MNC
1-8
12
36
SW SW SW
1/4 1/4 1/4

971 1012