

17

✓ 17

USE TYPEWRITER OR BALL POINT PEN. PRESS FIRMLY. PRINT CLEARLY.

WATER WELL RECORD  
KSA 82a-1201-1215


Kansas Department of Health and Environment-Division of Environment  
(Water well Contractors)  
Topeka, Kansas 66620

ada

1. Location of well: County: Jackson Fraction: NE 1/4 SE 1/4 NE 1/4 Section number: 26 Township number: T 8 S Range number: R 13 E/W

2. Distance and direction from nearest town or city: \_\_\_\_\_  
Street address of well location if in city: \_\_\_\_\_

3. Owner of well: Booth James  
R.R. or street: Rt. Box 61  
City, state, zip code: Delia Ks.

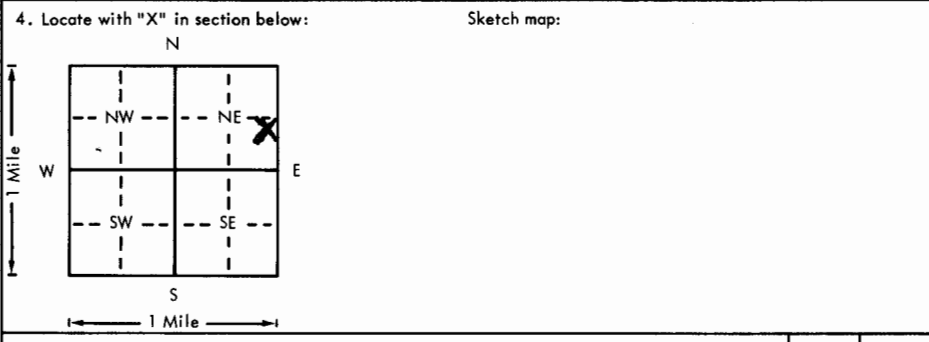

6. Bore hole dia. 10 in. Completion date 11/8/76  
Well depth 45 ft.

7.  Cable tool  Rotary  Driven  Dug  
 Hollow rod  Jetted  Bored  Reverse rotary

8. Use:  Domestic  Public supply  Industry  
 Irrigation  Air conditioning  Stock  
 Lawn  Oil field water  Other

9. Casing: Material PVC Height: Above or below  
Threaded  Welded  Surface 60 in.  
RMP  PVC  Weight Sch 40 /ft.  
Dia. 2 in. to 25 ft. depth Wall Thickness: inches or  
Dia.  in. to  ft. depth gage No. \_\_\_\_\_

5. Type and color of material	From	To
Top soil	0	2
Brown clay	2	4
Brown clay with F. sand	4	8
Sand and F. sand lime Gravel	8	21
Gray shale with C. sand	11	15
C. sand and Gravel	15	18
Gray sand shale	18	30
Red shale	30	44
Lime Rock	44	45
(Use a second sheet if needed)		

10. Screen: Manufacturer's name Morden  
Pipe  
Type PVC Dia. 5"  
Slot/gauze 1/8" Length 30  
Set between 25 ft. and 45 ft.  
ft. and \_\_\_\_\_ ft.  
Gravel pack Yes Size range of material 1/4"

11. Static water level: \_\_\_\_\_ mo./day/yr.  
7 ft. below land surface Date 11/8/76

12. Pumping level below land surfaces:  
\_\_\_\_\_ ft. after \_\_\_\_\_ hrs. pumping \_\_\_\_\_ g.p.m.  
\_\_\_\_\_ ft. after \_\_\_\_\_ hrs. pumping \_\_\_\_\_ g.p.m.  
Estimated maximum yield 1 g.p.m.

13. Water sample submitted: \_\_\_\_\_ mo./day/yr.  
Yes  No  Date \_\_\_\_\_

14. Well head completion:  
 Pitless adapter \_\_\_\_\_ Inches above grade

15. Well grouted? Yes  
With:  Neat cement  Bentonite  Concrete  
Depth: From 2 ft. to 12 ft.

16. Nearest source of possible contamination:  
ft. \_\_\_\_\_ Direction \_\_\_\_\_ Type NONE  
Well disinfected upon completion?  Yes  No

17. Pump:  Not installed  
Manufacturer's name \_\_\_\_\_  
Model number \_\_\_\_\_ HP \_\_\_\_\_ Volts \_\_\_\_\_  
Length of drop pipe \_\_\_\_\_ ft. capacity \_\_\_\_\_ g.p.m.  
Type:  
 Submersible  Turbine  
 Jet  Reciprocating  
 Centrifugal  Other

18. Elevation: 1977'  
Topography:  
 Hill  
 Slope  
 Upland  
 Valley

19. Remarks: Slab will be installed by customer

20. Water well contractor's certification:  
This well was drilled under my jurisdiction and this report is true to the best of my knowledge and belief.  
Cummings Drilling Co License No. 145  
Business name \_\_\_\_\_  
Address Delia, Topeka, Ks.  
Signed [Signature] Date 12/15/76  
Authorized representative

T 8 S R 13 E/W

Forward the white, blue and pink copies to the Department of Health and Environment

Form WWC-5