


1 LOCATION OF WATER WELL: Fraction NE 1/4 SW 1/4 NE 1/4 Section Number 7 Township Number T 10 S Range Number R 9 EW County: POTTAWATOMIE

Distance and direction from nearest town or city street address of well if located within city? 5 MILES EAST OF MANHATTAN ON HWY 24 SOUTH 1/8 ON HODGES LN

2 WATER WELL OWNER: TONY REED RR#, St. Address, Box #: 8964 GREEN VALLEY DR. City, State, ZIP Code: MANHATTAN, KS 66502 Board of Agriculture, Division of Water Resources Application Number: _____

3 LOCATE WELL'S LOCATION WITH AN "X" IN SECTION BOX: 4 DEPTH OF COMPLETED WELL 71 ft. ELEVATION: _____

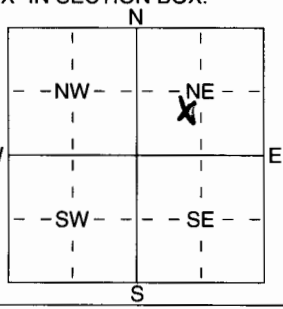

Depth(s) Groundwater Encountered 1 55 ft. 2 _____ ft. 3 _____ ft. WELL'S STATIC WATER LEVEL 50 ft. below land surface measured on mo/day/yr 6/13/06 Pump test data: Well water was _____ ft. after _____ hours pumping _____ gpm Est. Yield 30 gpm: Well water was _____ ft. after _____ hours pumping _____ gpm WELL WATER TO BE USED AS: 1 Domestic 3 Feedlot 6 Oil field water supply 9 Dewatering 12 Other (Specify below) 2 Irrigation 4 Industrial 7 Domestic (lawn & garden) 10 Monitoring well

Was a chemical/bacteriological sample submitted to Department? Yes _____ No [X]; If yes, mo/day/yr sample was submitted Water Well Disinfected? Yes _____ No [X]

5 TYPE OF BLANK CASING USED: 1 Steel 3 RMP (SR) 5 Wrought iron 8 Concrete tile CASING JOINTS: Glued [X] Clamped _____ 2 PVC 4 ABS 7 Fiberglass 9 Other (specify below) Welded _____ Threaded _____

Blank casing diameter 5 in. to 5.1 in. Dia _____ in. to _____ in. Dia _____ in. to _____ in. Casing height above land surface 28 in., weight _____ lbs./ft. Wall thickness or gauge No. SDR 21

TYPE OF SCREEN OR PERFORATION MATERIAL: 1 Steel 3 Stainless Steel 5 Fiberglass 8 RMP (SR) 10 Asbestos-Cement 2 Brass 4 Galvanized Steel 6 Concrete tile 9 ABS 12 None used (open hole)

SCREEN OR PERFORATION OPENINGS ARE: 1 Continuous slot 4 Mill slot 5 Guazed wrapped 8 Saw cut 11 None (open hole) 2 Louvered shutter 7 Torch cut 6 Wire wrapped 9 Drilled holes 10 Other (specify) _____ ft.

SCREEN-PERFORATED INTERVALS: From 51 ft. to 71 ft., From _____ ft. to _____ ft. GRAVEL PACK INTERVALS: From 25 ft. to 71 ft., From _____ ft. to _____ ft.

6 GROUT MATERIAL: 1 Neat cement 2 Cement grout 3 Bentonite 4 Other _____ Grout intervals: From 3 ft. to 25 ft., From _____ ft. to _____ ft.

What is the nearest source of possible contamination: 1 Septic tank 4 Lateral lines 7 Pit privy 10 Livestock pens 14 Abandoned water well 2 Sewer lines 5 Cess pool 8 Sewage lagoon 11 Fuel storage 15 Oil well/Gas well 3 Watertight sewer lines 6 Seepage pit 9 Feedyard 12 Fertilizer storage 13 Insecticide storage 16 Other (specify below) HOUSE Direction from well? EAST How many feet? 50

FROM	TO	LITHOLOGIC LOG	FROM	TO	PLUGGING INTERVALS
0	3	CLAYEY SILT W/ SAND			
3	25	SAND, FINE			
25	32	CLAYEY SILT			
32	50	SAND, FINE			
50	61	SAND, MEDIUM TO COARSE GRAIN BOUNDARIES			
61	64	CLAY, GRAY			
64	70	SAND MEDIUM TO COARSE GRAIN BOUNDARIES			
70	71	SILT, GRAY			

7 CONTRACTOR'S OR LANDOWNER'S CERTIFICATION: This water well was (1) constructed, (2) reconstructed, or (3) plugged under my jurisdiction and was completed on (mo/day/year) 6/13/06 and this record is true to the best of my knowledge and belief. Kansas Water Well Contractor's Licence No 760 This Water Well Record was completed on (mo/day/yr) 7/5/06 under the business name of ASSOCIATED DRILLING INC by (signature)