


1 LOCATION OF WATER WELL: County: JACKSON	Fraction SW 1/4 SW 1/4 NW 1/4	Section Number 1	Township Number T 8 S	Range Number R 14 E/W
--	----------------------------------	---------------------	--------------------------	--------------------------

Distance and direction from nearest town or city street address of well if located within city?  
5 south, 3 1/2 west of Holton

2 WATER WELL OWNER: Rick Mercer - Otis Bowser  
RR#, St. Address, Box #: Rt. 1 Box 295  
City, State, ZIP Code: Holton, KS 66436  
Board of Agriculture, Division of Water Resources  
Application Number:

3 LOCATE WELL'S LOCATION WITH AN "X" IN SECTION BOX:

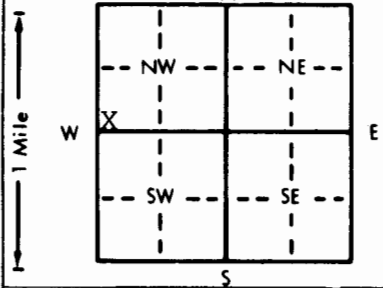

4 DEPTH OF COMPLETED WELL... 58' ft. ELEVATION: ...  
Depth(s) Groundwater Encountered 1... 14' ft. 2... ft. 3... ft.  
WELL'S STATIC WATER LEVEL... 10' ft. below land surface measured on mo/day/yr 5-11-92  
Pump test data: Well water was ... ft. after ... hours pumping ... gpm  
Est. Yield .3 ... gpm: Well water was ... ft. after ... hours pumping ... gpm  
Bore Hole Diameter .8 3/4 in. to ... ft., and ... in. to ... ft.  
WELL WATER TO BE USED AS:  
1 Domestic 3 Feedlot 6 Oil field water supply 9 Dewatering 12 Other (Specify below)  
2 Irrigation 4 Industrial 7 Lawn and garden only 10 Monitoring well  
Was a chemical/bacteriological sample submitted to Department? Yes... No... X... If yes, mo/day/yr sample was submitted  
Water Well Disinfected? Yes X No

5 TYPE OF BLANK CASING USED:  
1 Steel 3 RMP (SR) 5 Wrought iron 8 Concrete tile CASING JOINTS: Glued X Clamped  
2 PVC 4 ABS 6 Asbestos-Cement 9 Other (specify below) Welded  
7 Fiberglass Threaded

Blank casing diameter 5" in. to 0-14 ft., Dia 5" in. to 24-57 ft., Dia ... in. to ... ft.  
Casing height above land surface 24" in., weight 2.82 lbs./ft. Wall thickness or gauge No. 258

TYPE OF SCREEN OR PERFORATION MATERIAL:  
1 Steel 3 Stainless steel 5 Fiberglass 7 PVC 10 Asbestos-cement  
2 Brass 4 Galvanized steel 6 Concrete tile 8 RMP (SR) 11 Other (specify)  
9 ABS 12 None used (open hole)

SCREEN OR PERFORATION OPENINGS ARE:  
1 Continuous slot 3 Mill slot 5 Gauzed wrapped 8 Saw cut 11 None (open hole)  
2 Louvered shutter 4 Key punched 6 Wire wrapped 9 Drilled holes  
7 Torch cut 10 Other (specify)

SCREEN-PERFORATED INTERVALS: From 14 ft. to 24 ft., From ... ft. to ... ft.  
From 57 ft. to 58 ft., From ... ft. to ... ft.  
GRAVEL PACK INTERVALS: From 12 ft. to 58 ft., From ... ft. to ... ft.  
From ... ft. to ... ft., From ... ft. to ... ft.

6 GROUT MATERIAL: 1 Neat cement 2 Cement grout 3 Bentonite 4 Other  
Grout intervals: From 0 ft. to 12 ft., From ... ft. to ... ft., From ... ft. to ... ft.

What is the nearest source of possible contamination:  
1 Septic tank 4 Lateral lines 7 Pit privy 10 Livestock pens 14 Abandoned water well  
2 Sewer lines 5 Cess pool 8 Sewage lagoon 11 Fuel storage 15 Oil well/Gas well  
3 Watertight sewer lines 6 Seepage pit 9 Feedyard 12 Fertilizer storage 16 Other (specify below)  
13 Insecticide storage pond

Direction from well? north How many feet? 110'

FROM	TO	LITHOLOGIC LOG	FROM	TO	PLUGGING INTERVALS
0	14	Clay-Brown			
14	15	Cherty Limestone-loose			NOTE: 5-12-92 Received permission to shallow grout 12' from Don Taylor
15	23	Shale-Yellow			
23	30	Shale-Grey			
30	32	Limestone-Grey			
32	42	Shale-Grey			
42	43	Limestone-Grey			
43	58	Shale-Grey			

7 CONTRACTOR'S OR LANDOWNER'S CERTIFICATION: This water well was (1) constructed, (2) reconstructed, or (3) plugged under my jurisdiction and was completed on (mo/day/year) 5-11-92 and this record is true to the best of my knowledge and belief. Kansas Water Well Contractor's License No. 182 This Water Well Record was completed on (mo/day/yr) 6-8-92 under the business name of STRADER DRILLING CO., INC. by (signature) Dale Baker