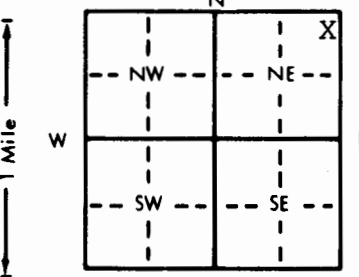


1 LOCATION OF WATER WELL: Fraction NE 1/4 NE 1/4 NE 1/4 Section Number 5 Township Number T 8 S Range Number R 15 **EW**
 County: JACKSON

Distance and direction from nearest town or city street address of well if located within city?
 5 1/4 south, 1-1/8 W of Holton

2 WATER WELL OWNER: Dennis Bowser
 RR#, St. Address, Box # : Rt. 1 Box 296 Board of Agriculture, Division of Water Resources
 City, State, ZIP Code : Holton, KS 66436 Application Number:

3 LOCATE WELL'S LOCATION WITH AN "X" IN SECTION BOX:

 4 DEPTH OF COMPLETED WELL... 100' ft. ELEVATION:
 Depth(s) Groundwater Encountered 1... 18' ft. 2... ft. 3... ft.
 WELL'S STATIC WATER LEVEL... 15' ft. below land surface measured on mo/day/yr... 1-17-90
 Pump test data: Well water was... ft. after... hours pumping... gpm
 Est. Yield .20 GPH ~~gpm~~ Well water was... ft. after... hours pumping... gpm
 Bore Hole Diameter... 8 3/4" in. to... ft., and... in. to... ft.
 WELL WATER TO BE USED AS: 5 Public water supply 8 Air conditioning 11 Injection well
 1 Domestic 3 Feedlot 6 Oil field water supply 9 Dewatering 12 Other (Specify below)
 2 Irrigation 4 Industrial 7 Lawn and garden only 10 Monitoring well
 Was a chemical/bacteriological sample submitted to Department? Yes... No...; If yes, mo/day/yr sample was submitted
 Water Well Disinfected? Yes No

5 TYPE OF BLANK CASING USED:
 1 Steel 3 RMP (SR) 5 Wrought iron 8 Concrete tile CASING JOINTS: Glued... Clamped...
 2 PVC 4 ABS 6 Asbestos-Cement 9 Other (specify below) Welded...
 7 Fiberglass Threaded...
 Blank casing diameter... 5" in. to... 0-16... ft., Dia... 5" in. to... 36-79... ft., Dia... 5" in. to... 80-100... ft.
 Casing height above land surface... 24" in., weight... 2.82... lbs./ft. Wall thickness or gauge No... 258
 TYPE OF SCREEN OR PERFORATION MATERIAL:
 1 Steel 3 Stainless steel 5 Fiberglass 7 PVC 10 Asbestos-cement
 2 Brass 4 Galvanized steel 6 Concrete tile 8 RMP (SR) 11 Other (specify)...
 9 ABS 12 None used (open hole)
 SCREEN OR PERFORATION OPENINGS ARE:
 1 Continuous slot 3 Mill slot 5 Gauzed wrapped 8 Saw cut 11 None (open hole)
 2 Louvered shutter 4 Key punched 6 Wire wrapped 9 Drilled holes
 7 Torch cut 10 Other (specify)...
 SCREEN-PERFORATED INTERVALS: From... 16... ft. to... 36... ft., From... ft. to... ft.
 From... 79... ft. to... 80... ft., From... ft. to... ft.
 GRAVEL PACK INTERVALS: From... 14... ft. to... 100... ft., From... ft. to... ft.
 From... ft. to... ft., From... ft. to... ft.

6 GROUT MATERIAL: 1 Neat cement 2 Cement grout 3 Bentonite 4 Other hole plug
 Grout Intervals: From... 0... ft. to... 14... ft., From... ft. to... ft., From... ft. to... ft.
 What is the nearest source of possible contamination:
 1 Septic tank 4 Lateral lines 7 Pit privy 10 Livestock pens 14 Abandoned water well
 2 Sewer lines 5 Cess pool 8 Sewage lagoon 11 Fuel storage 15 Oil well/Gas well
 3 Watertight sewer lines 6 Seepage pit 9 Feedyard 12 Fertilizer storage 16 Other (specify below)
 13 Insecticide storage
 Direction from well? South How many feet? 74'

FROM	TO	LITHOLOGIC LOG	FROM	TO	PLUGGING INTERVALS
0	56	Clay-Brown			
56	59	Limestone-Brown			1-29-90
59	67	Shale-Grey			NOTE: Received permission from Don Taylor to grout to 14'
67	70	Limestone-Brown			
70	73	Shale-Grey			
73	82	Shale-Red			
82	100	Shale-Grey			

7 CONTRACTOR'S OR LANDOWNER'S CERTIFICATION: This water well was (1) constructed, (2) reconstructed, or (3) plugged under my jurisdiction and was completed on (mo/day/year)... 1-17-90... and this record is true to the best of my knowledge and belief. Kansas Water Well Contractor's License No. ... 182... This Water Well Record was completed on (mo/day/yr) 2-9-90... under the business name of STRADER DRILLING CO., INC. by (signature) *Don Taylor*

OFFICE USE ONLY
T
R
EW
SEC.