27

USE TYPEWRITER OR BALL POINT PEN-PRESS FIRMLY, PRINT CLEARLY.

T R EW sec 1/4 1/4 1/4 No.

WATER WELL RECORD
KSA 82a-1201-1215

Kansas State Dept. Of Health
(Water Well Contractors)
Forbes-Bldg. 740
Topeka, Kansas 66620

ada

1 Location of well:	County	Township name	Fraction	Section number	Town number	Range number
	Jackson		NE*SE-NE	12	T8S	R15E

Distance and direction from nearest town or city:

Street address of well location if in city:

3 Owner of well: Jackson, Rolland
Address: Rural Route 1 Mayetta, Ks.

Locate with "X" in section below:

Sketch map:

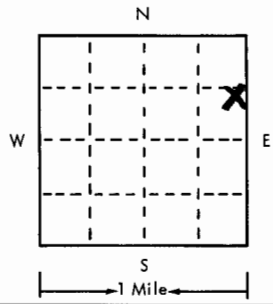

4 Well depth: 48 ft. Date of completion 3/4/76
Well diameter 10 in.

5 [X] Cable tool [ ] Rotary [ ] Driven [ ] Dug
[ ] Hollow rod [ ] Jetted [ ] Bored [ ] Reverse rotary

6 Use: [X] Domestic [ ] Public supply [ ] Industry
[ ] Irrigation [ ] Air conditioning [ ] Commercial
[ ] Test well [ ] _____

7 Casing: Material Steel Height: above/below
Threaded [ ] Welded [X] Surface 18 in.
Diam. Weight 13 lbs./ft.
___ in. to ___ ft. depth Drive shoe? [ ] Yes [X] No
___ in. to ___ ft. depth

2

Type and color of material	From	To
Top Soil	0	2
Yellow Clay	2	8
Yellow Clay and Sand	8	17
Yellow Clay, sand and gravel	17	23
Quick Sand	23	38
Coarse Sand	38	43
Gray Shale	43	48
(use a second sheet if needed)		

8 Screen:
Manufacturer Steel Pipe & Supply
Type Steel Dia. 6-5/8
Slot/gauze 1/2 hole Length 7
Set between 35 ft. and 42 ft.
Fittings:
Gravel pack [X] Yes [ ] No Size range of material 1/2

9 Static water level:
32 ft. below land surface Date 3/4/76

10 Pumping level below land surfaces:
32 ft. after 32 hrs. pumping 12 g.p.m.
___ ft. after ___ hrs. pumping ___ g.p.m.
Estimated maximum yield 12 g.p.m.

11 Water sample submitted:
[ ] Yes [X] No Date _____

12 Well head completion:
[X] Pitless adapter [ ] Inches above grade

13 Well grouted? [X] Yes [ ] No
[X] Neat cement [ ] Bentonite [ ] _____
Depth: From 3 ft. to 13 ft.

14 Nearest source of possible contamination:
ft. 150 Direction Northwest Lugoon
Well disinfected upon completion? [X] Yes [ ] No

15 Pump: [ ] Not installed
Manufacturer's name Gould
Model number 7Eh HP 1/2 Volts 230
Length of drop pipe 42 ft. capacity 7 g.m.p.
Type:
[X] Submersible [ ] Turbine
[ ] Jet [ ] Reciprocating
[ ] Certrifugal [ ] Other

16 Remarks: elevation 1128 Slab to be installed by customer

Topography:
[X] Hill
[ ] Slope
[ ] Upland
[ ] Valley

17 Water well contractor's certification:
This well was drilled under my jurisdiction and this report is true to the best of my knowledge and belief.
Business name Cummings Drilling Co. License No. 148
Address Route 1 Topeka Ks.
Signed Jeanette Cummings Date 3/5/76
Authorized representative

15E 12 NE SE NE

Forward the white, blue and pink copies to the Kansas State Dept. Of Health.

Form WWC-5

677-H