83

USE TYPEWRITER OR BALL POINT PEN-PRESS FIRMLY, PRINT CLEARLY.

WATER WELL RECORD
KSA 82a-1201-1215

Kansas Department of Health and Environment-Division of Environment
(Water well Contractors)
Topeka, Kansas 66620

1. Location of well:	County	Fraction	Section number	Township number	Range number
	Jackson	NW-NW-NE ~~NW 1/4 NW 1/4 NW 1/4~~	15	T 8 S	R 15 E W

2. Distance and direction from nearest town or city: 2 N .5 E
Street address of well location if in city: OF MAYETTA

3. Owner of well: John Hill
R.R. or street: RR2 - MAYETTA, Ks. 66509
City, state, zip code:

4. Locate with "X" in section below:

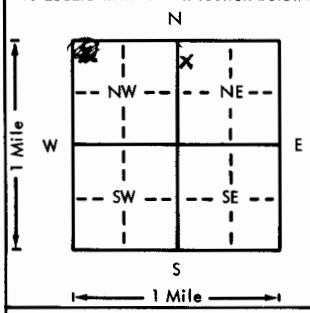

Sketch map:

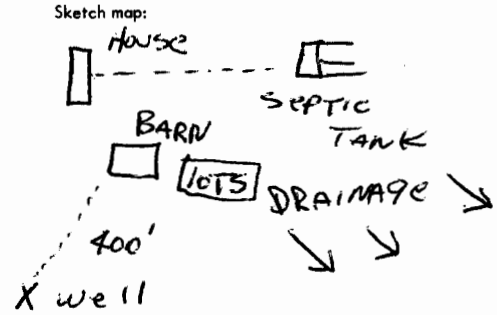

6. Bore hole dia. 10 in. Completion date
Well depth 60 ft. 4-5-76

7. __ Cable tool ✓ Rotary __ Driven __ Dug
__ Hollow rod __ Jetted __ Bored __ Reverse rotary

8. Use: ✓ Domestic __ Public supply __ Industry
__ Irrigation __ Air conditioning __ Stock
__ Lawn __ Oil field water __ Other

9. Casing: Material PVC Height: Above or below
Threaded ___ Welded ___ Surface 24 in.
RMP ___ PVC 9L Weight 2.58 lbs./ft.
Dia. 5 in. to 60 ft. depth Wall Thickness: inches or
Dia. ___ in. to ___ ft. depth gage No. 2.58

10. Screen: Manufacturer's name Rumpco
Type PVC Dia. 5"
Slot/gauze .025 Length 10
Set between 20 ft. and 30 ft.
___ ft. and ___ ft.
Gravel pack? ✓ Size range of material .030 x .060

11. Static water level: mo./day/yr.
20 ft. below land surface Date 4-5-76

12. Pumping level below land surfaces: Air Test
___ ft. after ___ hrs. pumping ___ g.p.m.
___ ft. after ___ hrs. pumping ___ g.p.m.
Estimated maximum yield 3 g.p.m.

13. Water sample submitted: mo./day/yr.
___ Yes X No Date X

14. Well head completion: Capped
___ Pitless adapter 24 Inches above grade

15. Well grouted? ✓
With: ✓ Neat cement ___ Bentonite ___ Concrete
Depth: From 0 ft. to 10 ft.

16. Nearest source of possible contamination:
ft. 400 Direction N Type Lots
Well disinfected upon completion? ✓ Yes ___ No

17. Pump: ✓ Not installed
Manufacturer's name
Model number ___ HP ___ Volts ___
Length of drop pipe ___ ft. capacity ___ g.p.m.
Type:
___ Submersible ___ Turbine
___ Jet ___ Reciprocating
___ Centrifugal ___ Other

5. Type and color of material

	From	To
Top Soil	0	3
Brown Clay	3	20
Sandy Clay	20	23
Course Sand - gravel	23	25
grey Lime	25	28
grey shale	28	49
grey Lime	49	57
grey shale	57	60

(Use a second sheet if needed)

18. Elevation: DA 1100
Topography:
___ Hill
___ Slope
___ Upland
✓ Valley

19. Remarks: owner will install slab

20. Water well contractor's certification:
This well was drilled under my jurisdiction and this report is true to the best of my knowledge and belief.
Business name: Strader Drlg Co Inc License No. 182
Address: RT 1 Holton, Ks
Signed: Dale Arkin Date 4-9-76
Authorized representative

T 8 R 15 E W Sec 15 1/4 1/4 1/4 NW NE

Forward the white, blue and pink copies to the Department of Health and Environment

Form WWC-5

BR = 1075 ▽ = 1080

MI-1023