

280

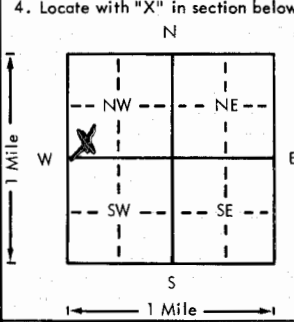
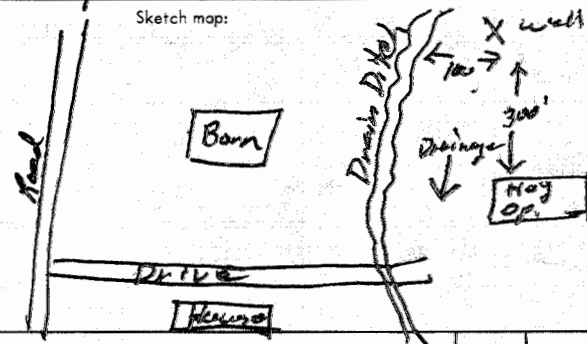
VBR  
✓

USE TYPEWRITER OR BALL POINT PEN-PRESS FIRMLY, PRINT CLEARLY.

WATER WELL RECORD  
KSA 82a-1201-1215

Kansas Department of Health and Environment-Division of Environment  
(Water well Contractors)  
Topeka, Kansas 66620

bec bbc (ote MAT

1. Location of well: County <b>Jackson</b>		Fraction <b>NW</b> <b>SW 1/4 SW 1/4 NW 1/4</b>	Section number <b>27</b>	Township number <b>T 8 S</b>	Range number <b>R 15 W</b>
2. Distance and direction from nearest town or city: <b>1 W 1/2 S</b> Street address of well location if in city: <b>Mayetta</b>			3. Owner of well: <b>B.M. Burkey</b> R.R. or street: <b>RR</b> City, state & zip code: <b>Mayetta, Ks. 66509</b>		
4. Locate with "X" in section below: 		Sketch map: 		6. Bore hole dia. <b>10</b> in. Completion date <b>5-19-78</b> Well depth <b>116</b> ft.	
5. Type and color of material		From	To	7. <input checked="" type="checkbox"/> Cable tool <input checked="" type="checkbox"/> Rotary <input type="checkbox"/> Driven <input type="checkbox"/> Dug <input type="checkbox"/> Hollow rod <input type="checkbox"/> Jetted <input type="checkbox"/> Bored <input type="checkbox"/> Reverse rotary	
<b>Top Soil</b>		<b>0</b>	<b>3</b>	8. Use: <input checked="" type="checkbox"/> Domestic <input type="checkbox"/> Public supply <input type="checkbox"/> Industry <input type="checkbox"/> Irrigation <input type="checkbox"/> Air conditioning <input type="checkbox"/> Stock <input type="checkbox"/> Lawn <input type="checkbox"/> Oil field water <input type="checkbox"/> Other	
<b>Black Loam</b>		<b>3</b>	<b>8</b>	9. Casing: Material <b>PVC</b> Height: <b>Above</b> or below Threaded <input type="checkbox"/> Welded <input type="checkbox"/> Surface <b>24</b> in. RMP <input type="checkbox"/> PVC <b>Blue</b> Weight <b>2.74</b> lbs./ft.	
<b>Black Silty Clay</b>		<b>8</b>	<b>21</b>	Dia. <b>5</b> in. to <b>116</b> ft. depth Wall Thickness: inches or Dia. <input type="checkbox"/> in. to <input type="checkbox"/> ft. depth gage No. <b>258</b>	
<b>Black Silt - Gray Sandy Clay</b>		<b>21</b>	<b>26</b>	10. Screen: Manufacturer's name <b>Pumpco</b> Type <b>PVC</b> Dia. <b>5"</b> Slot/gauze <b>0.20</b> Length <b>20'</b> Set between <b>96</b> ft. and <b>116</b> ft. ft. and <input type="checkbox"/> ft. Gravel pack? <b>YES</b> Size range of material <b>0.75/0.60</b>	
<b>Blue Silty Gravelly Clay</b>		<b>26</b>	<b>76</b>	11. Static water level: <input type="checkbox"/> mo./day/yr. <b>80</b> ft. below land surface Date <b>5-19-78</b>	
<b>Blue Fine Sand</b>		<b>76</b>	<b>89</b>	12. Pumping level below land surfaces: <b>Art Test</b> <input type="checkbox"/> ft. after <input type="checkbox"/> hrs. pumping <input type="checkbox"/> g.p.m. <input type="checkbox"/> ft. after <input type="checkbox"/> hrs. pumping <input type="checkbox"/> g.p.m. Estimated maximum yield <b>50</b> g.p.m.	
<b>Yellow &amp; Gray med-coarse Gravel</b>		<b>89</b>	<b>102</b>	13. Water sample submitted: <input type="checkbox"/> mo./day/yr. <input type="checkbox"/> Yes <input checked="" type="checkbox"/> No Date	
<b>Yellow med. Sand</b>		<b>102</b>	<b>106</b>	14. Well head completion: <b>Top Cap</b> <input type="checkbox"/> Pitless adapter <b>24</b> inches above grade	
<b>Red Gravel &amp; 1x2 Gravel</b>		<b>106</b>	<b>116</b>	15. Well grouted? <b>YES</b> With: <input checked="" type="checkbox"/> Neat cement <input type="checkbox"/> Bentonite <input type="checkbox"/> Concrete Depth: From <b>5</b> ft. to <b>15</b> ft.	
				16. Nearest source of possible contamination: ft. <b>100</b> Direction <b>W</b> Type <b>Drain Ditch</b> Well disinfected upon completion? <input checked="" type="checkbox"/> Yes <input type="checkbox"/> No	
				17. Pump: <input checked="" type="checkbox"/> Not installed Manufacturer's name <b>JAGUZZI</b> Model number <b>75415</b> HP <b>3/4</b> Volts <b>230</b> Length of drop pipe <b>105</b> ft. capacity <b>12</b> g.p.m. Type: <input checked="" type="checkbox"/> Submersible <input type="checkbox"/> Turbine <input type="checkbox"/> Jet <input type="checkbox"/> Reciprocating <input type="checkbox"/> Centrifugal <input type="checkbox"/> Other	
				20. Water well contractor's certification: This well was drilled under my jurisdiction and this report is true to the best of my knowledge and belief. <b>STRADER Dalg Co Inc 182</b> Business name License No. Address <b>RT 1 Halton, Ks</b> Signed <b>Dale Ashburn</b> Date <b>5-22-78</b> Authorized representative	
18. Elevation: <b>1104</b> Topography: <input type="checkbox"/> Hill <input type="checkbox"/> Slope <input type="checkbox"/> Upland <input checked="" type="checkbox"/> Valley		19. Remarks: <b>owner to install slab</b>			

(Use a second sheet if needed)

Forward the white, blue and pink copies to the Department of Health and Environment

Form WWC-5

1-8  
150  
27  
SW 1/4 NW 1/4

10