

WATER WELL RECORD

Form WWC-5


Division of Water Resources App. No.

1 LOCATION OF WATER WELL: County: Jackson	Fraction ¼ SE ¼ SE ¼ SW ¼	Section Number 20	Township No. T 8 S	Range Number R 15 <input checked="" type="checkbox"/> E <input type="checkbox"/> W
---	------------------------------	----------------------	-----------------------	---

Street/Rural Address of Well Location; if unknown, distance & direction from nearest town or intersection: If at owner's address, check here .

Global Positioning System (GPS) information:
 Latitude: 39.33482..... (in decimal degrees)
 Longitude: 95.76862..... (in decimal degrees)
 Elevation: 1140.....
 Datum: WGS 84, NAD 83, NAD 27
 Collection Method:
 GPS unit (Make/Model: Garmin.....)
 Digital Map/Photo, Topographic Map, Land Survey
 Est. Accuracy: <3 m, 3-5 m, 5-15 m, >15 m

2 WATER WELL OWNER: Prairie Band of Potawatomi
 RR#, Street Address, Box #: 16281 Q Rd.
 City, State, ZIP Code : Mavetta, KS 66509

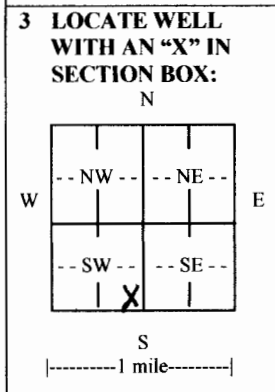

4 DEPTH OF COMPLETED WELL 300..... ft.
 Depth(s) Groundwater Encountered (1) no h2o..... ft. (2) na..... ft. (3) na..... ft.
 WELL'S STATIC WATER LEVEL na..... ft. below land surface measured on mo/day/yr.....
 Pump test data: Well water was.....ft. after..... hours pumping..... gpm
 EST. YIELD. na.....gpm. Well water was.....ft. after..... hours pumping..... gpm
 Bore Hole Diameter 6.....in. to 300.....ft., and na.....in. to na.....ft.
 WELL WATER TO BE USED AS: Public water supply Geothermal Injection well
 Domestic Feedlot Oil field water supply Dewatering Other (Specify below)
 Irrigation Industrial Domestic-lawn & garden Monitoring well
 Was a chemical/bacteriological sample submitted to Department? Yes No
 If yes, mo/day/yr sample was submitted.....
 Water well disinfected? Yes No

5 TYPE OF CASING USED: Steel PVC Other HDPE.....
 CASING JOINTS: Glued Clamped Welded Threaded
 Casing diameter 1..... in. to 300..... ft., Diameter na..... in. to na..... ft., Diameter na..... in. to na..... ft.
 Casing height above land surface below 48..... in., Weight na..... lbs./ft., Wall thickness or gauge No. SDR 11.....
 TYPE OF SCREEN OR PERFORATION MATERIAL:
 Steel Stainless Steel PVC Other (Specify)
 Brass Galvanized Steel None used (open hole)
 SCREEN OR PERFORATION OPENINGS ARE:
 Continuous slot Mill slot Gauze wrapped Torch cut Drilled holes None (open hole)
 Louvered shutter Key punched Wire wrapped Saw cut Other (specify)
 SCREEN-PERFORATED INTERVALS: From na..... ft. to na..... ft., From na..... ft. to na..... ft.
 From na..... ft. to na..... ft., From na..... ft. to na..... ft.
 GRAVEL PACK INTERVALS: From na..... ft. to na..... ft., From na..... ft. to na..... ft.
 From na..... ft. to na..... ft., From na..... ft. to na..... ft.

6 GROUT MATERIAL: Neat cement Cement grout Bentonite Other
 Grout Intervals: From 4..... ft. to 300..... ft., From na..... ft. to na..... ft., From na..... ft. to na..... ft.
 What is the nearest source of possible contamination:
 Septic tank Lateral lines Pit privy Livestock pens Insecticide storage Other (specify below)
 Sewer lines Cesspool Sewage lagoon Fuel storage Abandoned water well
 Watertight sewer lines Seepage pit Feedyard Fertilizer storage Oil well/gas well building.....
 Direction from well Distance from well

FROM	TO	LITHOLOGIC LOG	FROM	TO	LITHO. LOG (cont.) or PLUGGING INTERVALS
0	17	Clay, Brown	285	290	Shale, Red
17	32	Shale, Gray	290	295	Shale, Black
32	36	Limestone	295	300	Shale, Gray
36	80	Shale, Gray			
80	142	Sandstone			
142	175	Shale, Gray			
175	181	Limestone			
181	220	Shale, Gray			
220	223	Limestone			
223	285	Shale, Gray			

7 CONTRACTOR'S OR LANDOWNER'S CERTIFICATION: This water well was constructed, reconstructed, or plugged under my jurisdiction and was completed on (mo/day/year) 9-3-2009..... and this record is true to the best of my knowledge and belief. Kansas Water Well Contractor's License No. 760..... This Water Well Record was completed on (mo/day/year) 11-13-2009..... under the business name of Associated Drilling, Inc...... by (signature).....

INSTRUCTIONS: Use typewriter or ball point pen. *PLEASE PRESS FIRMLY* and *PRINT* clearly. Please fill in blanks and check the correct answers. Send three copies (white, blue, pink) to Kansas Department of Health and Environment, Bureau of Water, Geology Section, 1000 SW Jackson St., Suite 420, Topeka, Kansas 66612-1367. Telephone 785-296-5522. Send one copy to WATER WELL OWNER and retain one for your records. Include fee of \$5.00 for each constructed well. Visit us at <http://www.kdheks.gov/waterwell/index.html>.