



Jackson Co

466 23 737 84-150

# DENNIS L HANDKE

1820 NW 59th Terrace  
TOPEKA, KANSAS 66618  
785-286-4047 Home  
785-286-1990 Fax

Jessica Chapman  
Larsen & Associates  
1311 E. 25<sup>th</sup> Street, Suite B  
Lawrence, Kansas, 66046

June 20, 2014

RE: Monitor Well Elevation Survey  
15823 R. Road, Mayetta, Kansas

Proj. 14-00V  
Roediger Oil Co.  
U4-043-10008

Bench Mark: Chisled Sq.on SE corner of concrete sign base at East center of property.  
Elev: 1199.42      North 150.5      West 44.9      (from SE Cor. Sec. 22-8-15E)


MW-9	rim	1193.47	South	54.1	NE1/4,NE1/4,NE1/4,NE1/4 (27-8-15)
	top pipe	1193.14	West	305.9	Lat= 39.33219 Long = 95.72094
MW-10	rim	1197.70	North	251.2	SW1/4,SW1/4,SW1/4,SW1/4 (23-8-15)
	top pipe	1197.34	East	10.5	Lat= 39.33302 Long = 95.71982
MW-11	rim	1199.31	North	458.3	NE1/4,SE1/4,SE1/4,SE1/4
	top pipe	1198.73	West	148.3	Lat= 39.33359 Long = 95.72038
MW-12	rim	1202.32	North	586.0	NE1/4,SE1/4,SE1/4,SE1/4
	top pipe	1201.72	West	266.0	Lat= 39.33394 Long = 95.72080
MW-13	rim	1202.17	North	468.9	NE1/4,SE1/4,SE1/4,SE1/4
	top pipe	1201.73	West	306.5	Lat= 39.33362 Long = 95.72095
MW-14	rim	1202.45	North	386.5	NE1/4,SE1/4,SE1/4,SE1/4
	top pipe	1202.14	West	308.2	Lat= 39.33339 Long = 95.72095
MW-15	rim	1203.01	North	284.1	SE1/4,SE1/4,SE1/4,SE1/4
	top pipe	1202.79	East	306.5	Lat= 39.33311 Long = 95.72095
MW-16	rim	1203.14	North	146.1	SE1/4,SE1/4,SE1/4,SE1/4
	top pipe	1202.55	West	293.6	Lat= 39.33274 Long = 95.72090

Lat & Long derived existing Mayetta 7.5' quad map. NAVD 27

Elevation established from existing project.

If you have any questions, please feel free to call me. Thank you for the opportunity to be of service to you.

Dennis L Handke RLS

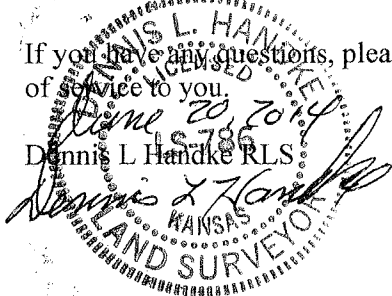

**State of Kansas**  
**KDHE/BER Well Tag Form**

Roediger Oil Co.

KDHE Project Code:

U	4	0	4	3	1	0	0	0	8
---	---	---	---	---	---	---	---	---	---

Well Tag Number

Well Number

Well Tag Number	Well Number
0050251	MW9
0050250	MW10
0050244	MW11
0050249	MW12
0050246	MW13
0050247	MW14
0050245	MW15
0050248	MW16

After completing this form, photocopy it and keep the copy for your files.  
Send the original to the address below.

Kansas Department of Health & Environment  
Bureau of Environmental Remediation  
1000 SW Jackson, Suite 410  
Topeka, KS 66612-1367