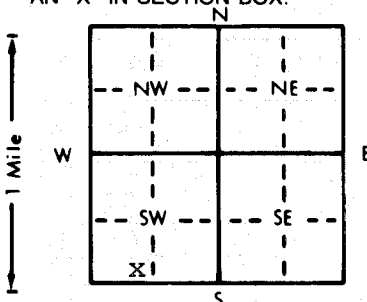


1 LOCATION OF WATER WELL: County: <u>Jackson</u>	Fraction <u>se 1/4 SW 1/4 SW 1/4</u>	Section Number <u>14</u>	Township Number <u>T 8 S</u>	Range Number <u>R 16</u> EW
---	---	-----------------------------	---------------------------------	---------------------------------------

Distance and direction from nearest town or city street address of well if located within city?
1/2 North and 6 1/8 East of Mayetta

2 WATER WELL OWNER: Jeff Jager
 RR#, St. Address, Box #: P.O. Box 17 Board of Agriculture, Division of Water Resources
 City, State, ZIP Code: Mayetta, Kansas 66509 Application Number:

3 LOCATE WELL'S LOCATION WITH AN "X" IN SECTION BOX:


4 DEPTH OF COMPLETED WELL: 80 ft. ELEVATION:
 Depth(s) Groundwater Encountered 1. 1 ft. 2. ft. 3. ft.
 WELL'S STATIC WATER LEVEL 10 ft. below land surface measured on mo/day/yr 8-10-95
 Pump test data: Well water was ft. after hours pumping gpm
 Est. Yield 3 gpm: Well water was ft. after hours pumping gpm
 Bore Hole Diameter 12 in. to 80 ft. and in. to ft.
 WELL WATER TO BE USED AS:
 1 Domestic 3 Feedlot 6 Oil field water supply 9 Dewatering 12 Other (Specify below)
 2 Irrigation 4 Industrial 7 Lawn and garden only 10 Monitoring well
 Was a chemical/bacteriological sample submitted to Department? Yes No X If yes, mo/day/yr. sample was submitted
 Water Well Disinfected? Yes X No

5 TYPE OF BLANK CASING USED:
 1 Steel 3 RMP (SR) 5 Wrought iron 8 Concrete tile CASING JOINTS: Glued X Clamped
 2 PVC 4 ABS 6 Asbestos-Cement 9 Other (specify below) Welded
 7 Fiberglass Threaded
 Blank casing diameter 5 in. to 14 ft. Dia. 5 in. to 24-80 ft. Dia. in. to ft.
 Casing height above land surface 24 in. weight 2.82 lbs./ft. Wall thickness or gauge No. 258
 TYPE OF SCREEN OR PERFORATION MATERIAL:
 1 Steel 3 Stainless steel 5 Fiberglass 7 PVC 10 Asbestos-cement
 2 Brass 4 Galvanized steel 6 Concrete tile 8 RMP (SR) 11 Other (specify)
 9 ABS 12 None used (open hole)
 SCREEN OR PERFORATION OPENINGS ARE:
 1 Continuous slot 3 Mill slot 5 Gauzed wrapped 8 Saw cut 11 None (open hole)
 2 Louvered shutter 4 Key punched 6 Wire wrapped 9 Drilled holes
 7 Torch cut 10 Other (specify)
 SCREEN-PERFORATED INTERVALS: From 14 ft. to 24 ft., From 78 ft. to 80 ft.
 From ft. to ft., From ft. to ft.
 GRAVEL PACK INTERVALS: From 13 ft. to 80 ft., From ft. to ft.
 From ft. to ft., From ft. to ft.

6 GROUT MATERIAL: 1 Neat cement 2 Cement grout 3 Bentonite 4 Other
 Grout Intervals: From 0 ft. to 13 ft., From ft. to ft., From ft. to ft.
 What is the nearest source of possible contamination:
 1 Septic tank 4 Lateral lines 7 Pit privy 10 Livestock pens 14 Abandoned water well
 2 Sewer lines 5 Cess pool 8 Sewage lagoon 11 Fuel storage 15 Oil well/Gas well
 3 Watertight sewer lines 6 Seepage pit 9 Feedyard 12 Fertilizer storage 16 Other (specify below)
 13 Insecticide storage drainage ditch
 Direction from well? West How many feet? 120

FROM	TO	LITHOLOGIC LOG	FROM	TO	PLUGGING INTERVALS
0	1	Top Soil			
1	14	brown clay			
14	16	brown fine to coarse sand, med to pea gravel			
16	18	grey shale			
18	20	grey limestone			
20	23	grey shale			
23	25	grey limestone			
25	41	grey shale			
41	47	grey limestone			
47	56	grye shale			
56	65	grey limestone			
65	80	grye shale			

Note: Permission to shallow grout from Don Taylor 8-14-95

7 CONTRACTOR'S OR LANDOWNER'S CERTIFICATION: This water well was (1) constructed, (2) reconstructed, or (3) plugged under my jurisdiction and was completed on (mo/day/year) 8-10-95 and this record is true to the best of my knowledge and belief. Kansas Water Well Contractor's License No. 182 This Water Well Record was completed on (mo/day/yr) 9-10-95 under the business name of Strader Drilling Co., Inc. by (signature) [Signature]

INSTRUCTIONS: Use typewriter or ball point pen. PLEASE PRESS FIRMLY and PRINT clearly. Please fill in blanks, underline or circle the correct answers. Send top three copies to Kansas Department of Health and Environment, Bureau of Water, Topeka, Kansas 66620-0001. Telephone: 913-296-5545. Send one to WATER WELL OWNER and retain one for your records.

OFFICE USE ONLY