


1 LOCATION OF WATER WELL: Fraction SE 1/4 NE 1/4 NW 1/4 Section Number 27 Township Number T 8 S Range Number R 16 EW
 County: JACKSON

Distance and direction from nearest town or city street address of well if located within city?
 4 1/4 south of Denison

2 WATER WELL OWNER: Delbert Davidson
 RR#, St. Address, Box # : P.O. Box 229 Board of Agriculture, Division of Water Resources
 City, State, ZIP Code : Hoyt, KS 66440 Application Number:

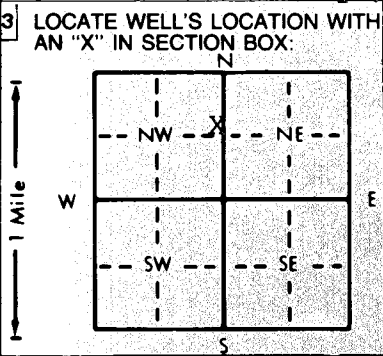

4 DEPTH OF COMPLETED WELL 60' ft ELEVATION:
 Depth(s) Groundwater Encountered 1 53' ft 2 ft 3 ft
 WELL'S STATIC WATER LEVEL 17' ft below land surface measured on mo/day/yr 11-02-93
 Pump test data: Well water was ft after hours pumping gpm
 Est. Yield 30 gpm Well water was ft after hours pumping gpm
 Bore Hole Diameter 10" in to ft and in to ft
 WELL WATER TO BE USED AS: 5 Public water supply 8 Air conditioning 11 Injection well
 1 Domestic 3 Feedlot 6 Oil field water supply 9 Dewatering 12 Other (Specify below)
 2 Irrigation 4 Industrial 7 Lawn and garden only 10 Monitoring well
 Was a chemical/bacteriological sample submitted to Department? Yes No If yes, mo/day/yr sample was submitted
 Water Well Disinfected? Yes No

5 TYPE OF BLANK CASING USED:
 1 Steel 3 RMP (SR) 5 Wrought iron 6 Concrete tile CASING JOINTS: Glued Clamped
 2 PVC 4 ABS 6 Asbestos-Cement 9 Other (specify below) Welded
 7 Fiberglass Threaded
 Blank casing diameter 5" in to 0-52 ft Dia in to ft Dia in to ft
 Casing height above land surface 24" in, weight 2.82 lbs/ft Wall thickness or gauge No 258
 TYPE OF SCREEN OR PERFORATION MATERIAL:
 1 Steel 3 Stainless steel 5 Fiberglass 7 PVC 10 Asbestos-cement
 2 Brass 4 Galvanized steel 6 Concrete tile 8 RMP (SR) 11 Other (specify)
 9 ABS 12 None used (open hole)
 SCREEN OR PERFORATION OPENINGS ARE:
 1 Continuous slot 3 Mill slot 5 Gauzed wrapped 8 Saw cut 11 None (open hole)
 2 Louvered shutter 4 Key punched 6 Wire wrapped 9 Drilled holes
 7 Torch cut 10 Other (specify)
 SCREEN-PERFORATED INTERVALS: From 52 ft to 60 ft, From ft to ft
 GRAVEL PACK INTERVALS: From 24 ft to 60 ft, From ft to ft

6 GROUT MATERIAL: 1 Neat cement 2 Cement grout 3 Bentonite 4 Other
 Grout Intervals: From 4 ft to 24 ft, From ft to ft, From ft to ft
 What is the nearest source of possible contamination:
 1 Septic tank 4 Lateral lines 7 Pit privy 10 Livestock pens 14 Abandoned water well
 2 Sewer lines 5 Cess pool 8 Sewage lagoon 11 Fuel storage 15 Oil well/Gas well
 3 Watertight sewer lines 6 Seepage pit 9 Feedyard 12 Fertilizer storage 16 Other (specify below)
 13 Insecticide storage
 Direction from well? east How many feet? 325'

FROM	TO	LITHOLOGIC LOG	FROM	TO	PLUGGING INTERVALS
0	1	Top Soil			
1	49	Clay-Brown			
49	51	Fine sand-Coarse Sand			
51	54	FS-CS-Med-Pea Chert			
54	60	Shale-Grey			

7 CONTRACTOR'S OR LANDOWNER'S CERTIFICATION: This water well was (1) constructed, (2) reconstructed, or (3) plugged under my jurisdiction and was completed on (mo/day/year) 11-02-93 and this record is true to the best of my knowledge and belief. Kansas Water Well Contractor's License No. 182 This Water Well Record was completed on (mo/day/yr) 12-13-93 under the business name of STRADER DRILLING CO., INC. by (signature) Delbert Davidson

INSTRUCTIONS: Use typewriter or ball point pen. PLEASE PRESS FIRMLY and PRINT clearly. Please fill in blanks, underline or circle the correct answers. Send top three copies to Kansas Department of Health and Environment, Bureau of Water, Topeka, Kansas 66620-0001. Telephone: 913-296-5545. Send one to WATER WELL OWNER and retain one for your records.

OFFICE USE ONLY

T

R

EW

SEC

1/4

1/4

1/4