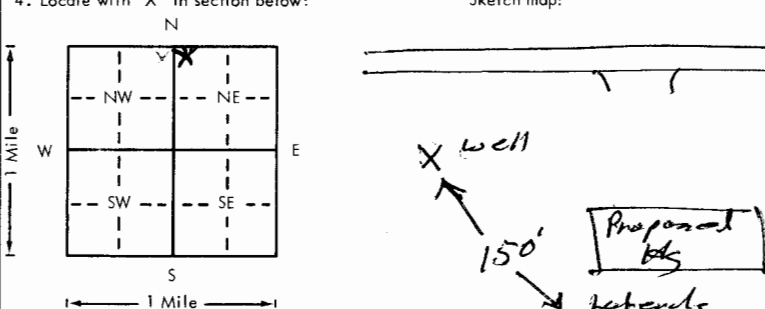


USE TYPEWRITER OR BALL
POINT PEN-PRESS FIRMLY,
PRINT CLEARLY.

WATER WELL RECORD
KSA 82a-1201-1215

Kansas Department of Health and
Environment-Division of Environment
(Water well Contractors)
Topeka, Kansas 66620

1. Location of well:		County <u>Jefferson</u>	Fraction <u>NW 1/4 NW 1/4 NE 1/4</u>	Section number <u>1</u>	Township number <u>T 8 S</u>	Range number <u>R 16 E</u>
2. Distance and direction from nearest town or city: <u>3 E</u>		3. Owner of well: <u>Henry J. Lerman</u>		R.R. or street: <u>1122 Allen Rd.</u>		
Street address of well location if in city: <u>Denison, KS</u>		City, state, zip code: <u>Independence, Mo. 64050</u>				
4. Locate with "X" in section below:		Sketch map:		6. Bore hole dia. <u>10</u> in. Completion date <u>7-17-78</u>		
				Well depth <u>80</u> ft.		
5. Type and color of material		From	To	7. <input checked="" type="checkbox"/> Cable tool <input checked="" type="checkbox"/> Rotary <input type="checkbox"/> Driven <input type="checkbox"/> Dug <input type="checkbox"/> Hollow rod <input type="checkbox"/> Jetted <input type="checkbox"/> Bored <input type="checkbox"/> Reverse rotary		
<u>Top Soil</u>		<u>0</u>	<u>1</u>	8. Use: <input checked="" type="checkbox"/> Domestic <input type="checkbox"/> Public supply <input type="checkbox"/> Industry <input type="checkbox"/> Irrigation <input type="checkbox"/> Air conditioning <input type="checkbox"/> Stock <input type="checkbox"/> Lawn <input type="checkbox"/> Oil field water <input type="checkbox"/> Other		
<u>Brown Clay</u>		<u>1</u>	<u>10</u>	9. Casing: Material <u>PVC</u> Height <u>Above</u> or below Threaded <input type="checkbox"/> Welded <input type="checkbox"/> Surface <u>24</u> in. RMP <u>PVC</u> <u>64</u> lbs./ft. Weight <u>2.74</u> lbs./ft. Dia. <u>5</u> in. to <u>80</u> ft. depth Wall Thickness: inches or Dia. <u>5</u> in. to <u>80</u> ft. depth gage No. <u>258</u>		
<u>Brown Fine Sandy Clay</u>		<u>10</u>	<u>15</u>	10. Screen: Manufacturer's name <u>Pumped</u> Type <u>PVC</u> Dia. <u>5"</u> Slot/gauze <u>020</u> Length <u>30</u> Set between <u>35</u> ft. and <u>65</u> ft. Gravel pack? <u>Yes</u> Size range of material <u>20/60</u>		
<u>Brown Clay</u>		<u>15</u>	<u>34</u>	11. Static water level: <u>30</u> ft. below land surface Date <u>7-17-78</u>		
<u>Yellow Sandy Gravelly Clay</u>		<u>34</u>	<u>38</u>	12. Pumping level below land surfaces: <u>At test</u> ____ ft. after ____ hrs. pumping ____ g.p.m. ____ ft. after ____ hrs. pumping ____ g.p.m. Estimated maximum yield <u>9 to 10</u> g.p.m.		
<u>Yellow Coarse Sand to Coarse Gravel</u>		<u>38</u>	<u>46</u>	13. Water sample submitted: ____ mo./day/yr. Yes <input checked="" type="checkbox"/> No <input type="checkbox"/> Date ____		
<u>Gray Clay</u>		<u>46</u>	<u>61</u>	14. Well head completion: <u>Top Cap</u> ____ Pitless adapter <u>24</u> inches above grade		
<u>limestone & Shale</u>		<u>61</u>	<u>80</u>	15. Well grouted? <u>Yes</u> With: <input checked="" type="checkbox"/> Neat cement <input type="checkbox"/> Bentonite <input type="checkbox"/> Concrete Depth: From <u>3</u> ft. to <u>13</u> ft.		
				16. Nearest source of possible contamination: ft. <u>150</u> Direction <u>SW</u> Type <u>leach</u> Well disinfected upon completion? <input checked="" type="checkbox"/> Yes <input type="checkbox"/> No		
				17. Pump: <input checked="" type="checkbox"/> Not installed Manufacturer's name ____ Model number ____ HP ____ Volts ____ Length of drop pipe ____ ft. capacity ____ g.p.m. Type: ____ Submersible ____ Turbine ____ Jet ____ Reciprocating ____ Centrifugal ____ Other		
18. Elevation: <u>1572</u>		19. Remarks: <u>owner to install slab</u>		20. Water well contractor's certification: This well was drilled under my jurisdiction and this report is true to the best of my knowledge and belief. <u>S. Trader Drilling Co</u> <u>182</u> Business name License No. Address <u>RT 1 Holton, Kans</u> Signed <u>Dale Roben</u> Date <u>7-18-78</u> Authorized representative		