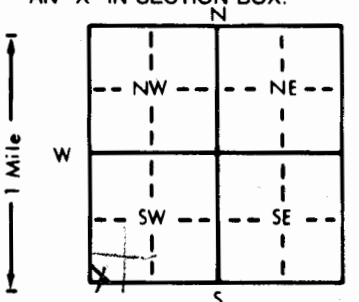


1 LOCATION OF WATER WELL: Fraction SW 1/4 SW 1/4 SW 1/4 Section Number 1 Township Number T 8 S Range Number R 16 E/W  
 County: JACKSON

Distance and direction from nearest town or city street address of well if located within city?  
2 1/2 MI. 2 1/2 N. 1/2 EAST - MAYETTA

2 WATER WELL OWNER: LESLIE A. OISEN Board of Agriculture, Division of Water Resources  
 RR#, St. Address, Box #: 15534 178th RD Application Number:  
 City, State, ZIP Code: MAYETTA KS 66509

3 LOCATE WELL'S LOCATION WITH AN "X" IN SECTION BOX:  
  
 4 DEPTH OF COMPLETED WELL: 34 ft. ELEVATION:  
 Depth(s) Groundwater Encountered 1. 12 ft. 2. . ft. 3. . ft.  
 WELL'S STATIC WATER LEVEL: 12 ft. below land surface measured on mo/day/yr 9/22/94  
 Pump test data: Well water was . ft. after . hours pumping . gpm  
 Est. Yield . gpm: Well water was . ft. after . hours pumping . gpm  
 Bore Hole Diameter: . in. to . ft., and . in. to . ft.  
 WELL WATER TO BE USED AS:  
 1 Domestic (circled) 3 Feedlot 6 Oil field water supply 9 Dewatering 12 Other (Specify below)  
 2 Irrigation 4 Industrial 7 Lawn and garden only 10 Monitoring well  
 Was a chemical/bacteriological sample submitted to Department? Yes . No (checked); If yes, mo/day/yr sample was submitted  
 Water Well Disinfected? Yes No

5 TYPE OF BLANK CASING USED:  
 1 Steel 3 RMP (SR) 5 Wrought iron 8 Concrete tile CASING JOINTS: Glued . Clamped .  
 2 PVC 4 ABS 6 Asbestos-Cement 9 Other (specify below) ROCK Welded .  
 7 Fiberglass Threaded .  
 Blank casing diameter: 36 in. to 34 ft., Dia . in. to . ft., Dia . in. to . ft.  
 Casing height above land surface: 0 in., weight . lbs./ft. Wall thickness or gauge No. .  
 TYPE OF SCREEN OR PERFORATION MATERIAL:  
 1 Steel 3 Stainless steel 5 Fiberglass 7 PVC 10 Asbestos-cement  
 2 Brass 4 Galvanized steel 6 Concrete tile 8 RMP (SR) 11 Other (specify) .  
 9 ABS 12 None used (open hole)  
 SCREEN OR PERFORATION OPENINGS ARE:  
 1 Continuous slot 3 Mill slot 5 Gauzed wrapped 8 Saw cut 11 None (open hole)  
 2 Louvered shutter 4 Key punched 6 Wire wrapped 9 Drilled holes  
 7 Torch cut 10 Other (specify) NA  
 SCREEN-PERFORATED INTERVALS: From NA ft. to NA ft., From . ft. to . ft.  
 From . ft. to . ft., From . ft. to . ft.  
 GRAVEL PACK INTERVALS: From . ft. to . ft., From . ft. to . ft.  
 From . ft. to . ft., From . ft. to . ft.

6 GROUT MATERIAL: 1 Neat cement 2 Cement grout 3 Bentonite (circled) 4 Other  
 Grout Intervals: From 5 ft. to 4 1/2 ft., From . ft. to . ft., From . ft. to . ft.  
 What is the nearest source of possible contamination:  
 1 Septic tank 4 Lateral lines 7 Pit privy 10 Livestock pens 14 Abandoned water well  
 2 Sewer lines 5 Cess pool 8 Sewage lagoon 11 Fuel storage 15 Oil well/Gas well  
 3 Watertight sewer lines 6 Seepage pit 9 Feedyard 12 Fertilizer storage 16 Other (specify below)  
None - located in pasture  
 Direction from well? How many feet?

FROM	TO	LITHOLOGIC LOG	FROM	TO	PLUGGING INTERVALS
			<u>34</u>	<u>12</u>	<u>Chlorinated Sand</u>
			<u>12</u>	<u>5</u>	<u>Subsoil</u>
			<u>5</u>	<u>4 1/2</u>	<u>BENTONITE CLAY</u>
			<u>4 1/2</u>	<u>0</u>	<u>SOIL</u>

7 CONTRACTOR'S OR LANDOWNER'S CERTIFICATION: This water well was (1) constructed, (2) reconstructed, or (3) plugged under my jurisdiction and was completed on (mo/day/year) . and this record is true to the best of my knowledge and belief. Kansas  
 Water Well Contractor's License No. 1500 This Water Well Record was completed on (mo/day/yr) 9/22/94  
 under the business name of KS V by (signature) Danny Rogers

INSTRUCTIONS: Use typewriter or ball point pen. PLEASE PRESS FIRMLY and PRINT clearly. Please fill in blanks, underline or circle the correct answers. Send top three copies to Kansas Department of Health and Environment, Bureau of Water, Topeka, Kansas 66620-0001. Telephone: 913-296-5545. Send one to WATER WELL OWNER and retain one for your records.

OFFICE USE ONLY