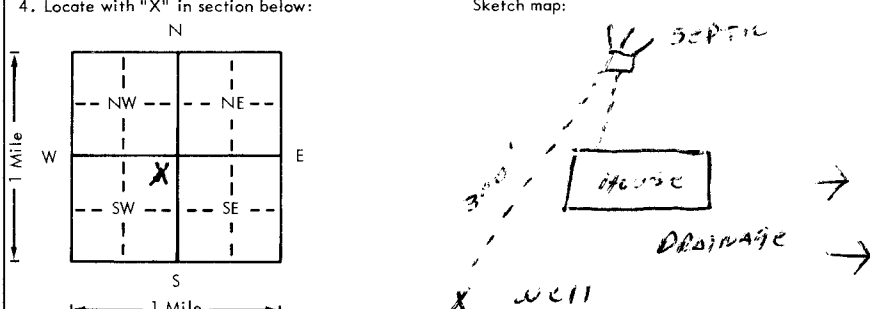


VBRT

USE TYPEWRITER OR BALL
POINT PEN-PRESS FIRMLY,
PRINT CLEARLY.

WATER WELL RECORD
KSA 82a-1201-1215

Kansas Department of Health and
Environment-Division of Environment
(Water well Contractors)
Topeka, Kansas 66620

| | | | | | | |
|---|--|---|---|---|---------------------------------|--|
| 1. Location of well: | | County <u>JEFFERSON</u> | Fraction <u>NE 1/4 NE 1/4 SW 1/4</u> | Section number <u>15</u> | Township number <u>T 8 S</u> | Range number <u>R 17 E</u> |
| 2. Distance and direction from nearest town or city: <u>2 NW</u> | | 3. Owner of well: <u>SCOTT MISENHUTER</u> | | R.R. or street: <u>RR 1</u> | | |
| Street address of well location if in city: <u>OF VALLEY FANS</u> | | City, state, zip code: <u>VALLEY FALLS, KS</u> | | | | |
| 4. Locate with "X" in section below: | | Sketch map: | | 6. Bore hole dia. <u>8</u> in. Completion date <u>2-28-78</u> Well depth <u>120</u> ft. | | |
|  | | | | 7. <input checked="" type="checkbox"/> Cable tool <input checked="" type="checkbox"/> Rotary <input type="checkbox"/> Driven <input type="checkbox"/> Dug <input type="checkbox"/> Hollow rod <input type="checkbox"/> Jetted <input type="checkbox"/> Bored <input type="checkbox"/> Reverse rotary | | |
| 5. Type and color of material | | From | | To | | 8. Use: <input checked="" type="checkbox"/> Domestic <input type="checkbox"/> Public supply <input type="checkbox"/> Industry <input type="checkbox"/> Irrigation <input type="checkbox"/> Air conditioning <input type="checkbox"/> Stock <input type="checkbox"/> Lawn <input type="checkbox"/> Oil field water <input type="checkbox"/> Other |
| <u>TOP SOIL</u> | | <u>0</u> | | <u>4</u> | | 9. Casing: Material <u>PVC</u> Height: <u>Above</u> or below Threading <u>Welded</u> Surface <u>24</u> in. RMP <u>PVC</u> Weight <u>250</u> lbs./ft. Dia. <u>5</u> in. to <u>120</u> ft. depth Wall Thickness: inches or Dia. <u>5</u> in. to <u>120</u> ft. depth gage No. <u>274, 258</u> |
| <u>CLAY BROWN</u> | | <u>4</u> | | <u>7</u> | | 10. Screen: Manufacturer's name <u>MPE, Tempec</u> Type <u>PVC</u> Dia. <u>5</u> Slot/gauze <u>.020</u> Length <u>40</u> Set between <u>20</u> ft. and <u>100</u> ft. Gravel pack? <input checked="" type="checkbox"/> Size range of material <u>10-20</u> |
| <u>SHALE, GRAY</u> | | <u>7</u> | | <u>35</u> | | 11. Static water level: <u>78</u> ft. below land surface Date <u>2-28-78</u> |
| <u>LIME STONE, GRAY</u> | | <u>35</u> | | <u>39</u> | | 12. Pumping level below land surfaces: ____ ft. after ____ hrs. pumping ____ g.p.m. ____ ft. after ____ hrs. pumping ____ g.p.m. Estimated maximum yield ____ g.p.m. |
| <u>SHALE, GRAY, BIK</u> | | <u>39</u> | | <u>78</u> | | 13. Water sample submitted: ____ mo./day/yr. Yes <input type="checkbox"/> No <input checked="" type="checkbox"/> Date ____ |
| <u>LIME STONE, SOFT, GRAY</u> | | <u>78</u> | | <u>80</u> | | 14. Well head completion: <u>CAP</u> ____ Pitless adapter <u>24</u> Inches above grade |
| <u>SHALE, GRAY</u> | | <u>80</u> | | <u>120</u> | | 15. Well grouted? <input checked="" type="checkbox"/> With: <input checked="" type="checkbox"/> Neat cement <input type="checkbox"/> Bentonite <input type="checkbox"/> Concrete Depth: From <u>0</u> ft. to <u>16</u> ft. |
| | | | | | | 16. Nearest source of possible contamination: ft. <u>300</u> Direction <u>NE</u> Type <u>SEPTIC</u> Well disinfected upon completion? <input checked="" type="checkbox"/> Yes <input type="checkbox"/> No |
| | | | | | | 17. Pump: ____ Not installed Manufacturer's name <u>WARDS</u> Model number ____ HP <u>1/2</u> Volts <u>230</u> Length of drop pipe <u>110</u> ft. capacity <u>14</u> g.p.m. Type: <input checked="" type="checkbox"/> Liquid level controls <input type="checkbox"/> Submersible <input type="checkbox"/> Turbine <input type="checkbox"/> Jet <input type="checkbox"/> Reciprocating <input type="checkbox"/> Centrifugal <input type="checkbox"/> Other |
| | | | | | | 20. Water well contractor's certification: This well was drilled under my jurisdiction and this report is true to the best of my knowledge and belief. <u>Strader Drilling Co</u> License No. <u>182</u> Business name <u>PT 1 Holton, KS</u> Address <u>Osage, Astoria</u> Date <u>3-27</u> Signed <u>Osage, Astoria</u> Authorized representative |
| 18. Elevation: <u>922</u> | | 19. Remarks: <u>OWNER TO INSTALL SLAB</u> | | | | |
| Topography: <input checked="" type="checkbox"/> Hill <input type="checkbox"/> Slope <input type="checkbox"/> Upland <input type="checkbox"/> Valley | | | | | | |

BR = 915
M = 854

8 17 15
NE NE SW
1/4 1/4 1/4