


1 LOCATION OF WATER WELL: Fraction SE 1/4 SE 1/4 SE 1/4 Section Number 29 Township Number T 8 S Range Number R 18 EW  
 County: Jefferson

Distance and direction from nearest town or city street address of well if located within city?  
North of North City Limits of Winchester, Ks

2 WATER WELL OWNER: Wm. Manville  
 RR#, St. Address, Box #: Box #253 Board of Agriculture, Division of Water Resources  
 City, State, ZIP Code: RR #2 Valley Falls, Ks 66088 Application Number:

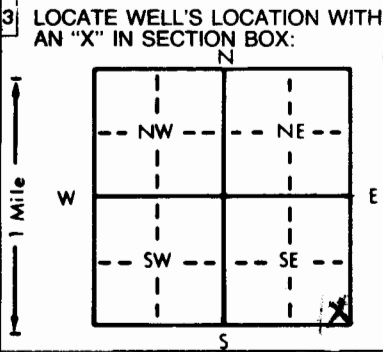

4 DEPTH OF COMPLETED WELL: 35 ft. ELEVATION:  
 Depth(s) Groundwater Encountered 1. 7 ft. 2. ft. 3. ft.  
 WELL'S STATIC WATER LEVEL: 7 ft. below land surface measured on mo/day/yr 3/12/92  
 Pump test data: Well water was ft. after hours pumping gpm  
 Est. Yield gpm: Well water was ft. after hours pumping gpm  
 Bore Hole Diameter: in. to 4 ft. and in. to ft.  
 WELL WATER TO BE USED AS:  
 1 Domestic (circled) 3 Feedlot 6 Oil field water supply 9 Dewatering 12 Other (Specify below)  
 2 Irrigation 4 Industrial 7 Lawn and garden only 10 Monitoring well  
 Was a chemical/bacteriological sample submitted to Department? Yes No  If yes, mo/day/yr sample was submitted  
 Water Well Disinfected?  Yes No

5 TYPE OF BLANK CASING USED:  
 1 Steel 3 RMP (SR) 5 Wrought iron 8 Concrete tile CASING JOINTS: Glued Clamped  
 2 PVC 4 ABS 6 Asbestos-Cement 9 Other (specify below) Welded  
 7 Fiberglass ROCK Threaded  
 Blank casing diameter 48" in. to ft., Dia. in. to ft., Dia. in. to ft.  
 Casing height above land surface 40 in., weight lbs./ft. Wall thickness or gauge No.  
 TYPE OF SCREEN OR PERFORATION MATERIAL:  
 1 Steel 3 Stainless steel 5 Fiberglass 8 RMP (SR) 10 Asbestos-cement  
 2 Brass 4 Galvanized steel 6 Concrete tile 9 ABS 12 None used (open hole)  
 11 Other (specify) ROCK  
 SCREEN OR PERFORATION OPENINGS ARE:  
 1 Continuous slot 3 Mill slot 5 Gauzed wrapped 8 Saw cut 11 None (open hole)  
 2 Louvered shutter 4 Key punched 6 Wire wrapped 9 Drilled holes  
 7 Torch cut 10 Other (specify) N/A  
 SCREEN-PERFORATED INTERVALS: From N/A ft. to N/A ft., From ft. to ft.  
 GRAVEL PACK INTERVALS: From ft. to ft., From ft. to ft.

6 GROUT MATERIAL: 1 Neat cement 2 Cement grout 3 Bentonite (circled) 4 Other  
 Grout Intervals: From 5 ft. to 4 1/2 ft., From ft. to ft., From ft. to ft.  
 What is the nearest source of possible contamination:  
 1 Septic tank 4 Lateral lines 7 Pit privy 10 Livestock pens 14 Abandoned water well  
 2 Sewer lines 5 Cess pool 8 Sewage lagoon 11 Fuel storage 15 Oil well/Gas well  
 3 Watertight sewer lines 6 Seepage pit 9 Feedyard 12 Fertilizer storage 16 Other (specify below) crop land  
 13 Insecticide storage  
 Direction from well? North How many feet? 10'

FROM	TO	LITHOLOGIC LOG	FROM	TO	PLUGGING INTERVALS
			<u>35</u>	<u>7</u>	<u>Chlorinated Sand</u>
			<u>7</u>	<u>5</u>	<u>Subsoil</u>
			<u>5</u>	<u>4 1/2</u>	<u>BENTONITE</u>
			<u>4 1/2</u>	<u>0</u>	<u>SOIL</u>

7 CONTRACTOR'S OR LANDOWNER'S CERTIFICATION: This water well was (1) constructed, (2) reconstructed, or (3) plugged (circled) under my jurisdiction and was completed on (mo/day/year) 3/12/92 and this record is true to the best of my knowledge and belief. Kansas Water Well Contractor's License No. 1500 This Water Well Record was completed on (mo/day/yr) 3/12/92 under the business name of Ksu by (signature) Danny H. Rogers