


1 LOCATION OF WATER WELL: County: Jefferson Fraction: NW 1/4 NW 1/4 NE 1/4 Section Number: 1 Township Number: T 8 S Range Number: R 19 E

Distance and direction from nearest town or city street address of well if located within city?  
5 miles south east of Norborne KS.

2 WATER WELL OWNER: RR#, St. Address, Box #: Don Davis 1012 E 22nd AVE Board of Agriculture, Division of Water Resources  
 City, State, ZIP Code: N.K.C mo. 64116 Application Number:

3 LOCATE WELL'S LOCATION WITH AN "X" IN SECTION BOX:

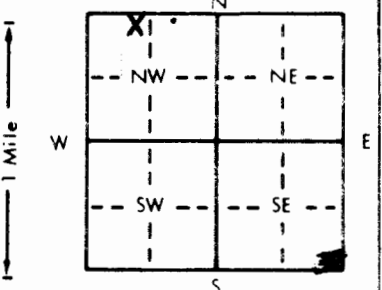

4 DEPTH OF COMPLETED WELL: 81 ft. ELEVATION:

Depth(s) Groundwater Encountered: 1 ft. 22 ft. 3 ft.

WELL'S STATIC WATER LEVEL: 15 ft. below land surface measured on mo/day/yr

Pump test data: Well water was \_\_\_\_\_ ft. after \_\_\_\_\_ hours pumping \_\_\_\_\_ gpm

Est. Yield: 3 gpm; Well water was \_\_\_\_\_ ft. after \_\_\_\_\_ hours pumping \_\_\_\_\_ gpm

Bore Hole Diameter: 9 in. to 81 in. to \_\_\_\_\_ in. to \_\_\_\_\_ in.

WELL WATER TO BE USED AS:  Domestic  3 Feedlot  6 Oil field water supply  9 Dewatering  12 Other (Specify below)

Was a chemical/bacteriological sample submitted to Department? Yes \_\_\_\_\_ No \_\_\_\_\_; If yes, mo/day/yr sample was submitted \_\_\_\_\_

Water Well Disinfected? Yes \_\_\_\_\_ No \_\_\_\_\_

5 TYPE OF BLANK CASING USED:  1 Steel  3 RMP (SR)  5 Wrought iron  8 Concrete tile CASING JOINTS: Glued  Clamped

2 PVC  4 ABS  6 Asbestos-Cement  9 Other (specify below) Welded \_\_\_\_\_

Blank casing diameter: 6 in. to \_\_\_\_\_ ft., Dia \_\_\_\_\_ in. to \_\_\_\_\_ ft., Dia \_\_\_\_\_ in. to \_\_\_\_\_ ft.

Casing height above land surface: 2 in., weight \_\_\_\_\_ lbs./ft. Wall thickness or gauge No. Sch #40

TYPE OF SCREEN OR PERFORATION MATERIAL:  PVC  10 Asbestos-cement

1 Steel  3 Stainless steel  5 Fiberglass  8 RMP (SR)  11 Other (specify) \_\_\_\_\_

2 Brass  4 Galvanized steel  6 Concrete tile  9 ABS  12 None used (open hole)

SCREEN OR PERFORATION OPENINGS ARE:  5 Gauzed wrapped  8 Saw cut  11 None (open hole)

1 Continuous slot  3 Mill slot  6 Wire wrapped  9 Drilled holes

2 Louvered shutter  4 Key punched  7 Torch cut  10 Other (specify) \_\_\_\_\_

SCREEN-PERFORATED INTERVALS: From 22 ft. to 81 ft., From \_\_\_\_\_ ft. to \_\_\_\_\_ ft.

GRAVEL PACK INTERVALS: From 18 ft. to 81 ft., From \_\_\_\_\_ ft. to \_\_\_\_\_ ft.

6 GROUT MATERIAL:  1 Neat cement  2 Cement grout  3 Bentonite  4 Other \_\_\_\_\_

Grout Intervals: From 3 ft. to 18 ft., From \_\_\_\_\_ ft. to \_\_\_\_\_ ft.

What is the nearest source of possible contamination: None

1 Septic tank  4 Lateral lines  7 Pit privy  10 Livestock pens  14 Abandoned water well

2 Sewer lines  5 Cess pool  8 Sewage lagoon  11 Fuel storage  15 Oil well/Gas well

3 Watertight sewer lines  6 Seepage pit  9 Feedyard  12 Fertilizer storage  16 Other (specify below) NONE

Direction from well? \_\_\_\_\_ How many feet? \_\_\_\_\_

FROM	TO	LITHOLOGIC LOG	FROM	TO	PLUGGING INTERVALS
0	3	TOP SOIL			
3	22	BROWN CLAY			
22	23	LIME STONE			
23	40	GRAY CLAY			
40	43	LIME STONE			
43	50	GRAY CLAY			
50	81	BLUE SHALE			

7 CONTRACTOR'S OR LANDOWNER'S CERTIFICATION: This water well was  constructed,  reconstructed, or  plugged under my jurisdiction and was completed on (mo/day/year) 3-29-92 and this record is true to the best of my knowledge and belief. Kansas Water Well Contractor's License No. 526 This Water Well Record was completed on (mo/day/yr) 4-16-92 under the business name of NOVA DRILLING by (signature) Fred Hall