


1 LOCATION OF WATER WELL: Fraction Section Number Township Number Range Number
 County: JEFFERSON NE 1/4 NE 1/4 SW 1/4 22 T 8 S R 19 E/W

Distance and direction from nearest town or city street address of well if located within city?
 1 mile north of Winchester

2 WATER WELL OWNER: Joe Sixta
 RR#, St. Address, Box # : 5510 Lathrop Board of Agriculture, Division of Water Resources
 City, State, ZIP Code : Kansas City, KS 66104 Application Number:

3 LOCATE WELL'S LOCATION WITH AN "X" IN SECTION BOX:

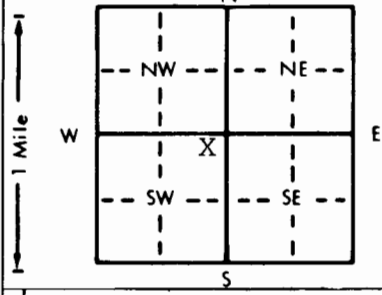

4 DEPTH OF COMPLETED WELL... 110' ft. ELEVATION:
 Depth(s) Groundwater Encountered 1... 48' ft. 2... ft. 3... ft.
 WELL'S STATIC WATER LEVEL... 40' ft. below land surface measured on mo/day/yr 11-22-91
 Pump test data: Well water was ... ft. after ... hours pumping ... gpm
 Est. Yield .8... gpm: Well water was ... ft. after ... hours pumping ... gpm
 Bore Hole Diameter... 12" in. to ... ft., and ... in. to ... ft.
 WELL WATER TO BE USED AS: 5 Public water supply 8 Air conditioning 11 Injection well
 1 Domestic 3 Feedlot 6 Oil field water supply 9 Dewatering 12 Other (Specify below)
 2 Irrigation 4 Industrial 7 Lawn and garden only 10 Monitoring well
 Was a chemical/bacteriological sample submitted to Department? Yes... No... ; If yes, mo/day/yr sample was submitted
 Water Well Disinfected? Yes No

5 TYPE OF BLANK CASING USED: 5 Wrought iron 8 Concrete tile CASING JOINTS: Glued Clamped
 1 Steel 3 RMP (SR) 6 Asbestos-Cement 9 Other (specify below) Welded
 2 PVC 4 ABS 7 Fiberglass Threaded
 Blank casing diameter... 5" in. to .0-40... ft., Dia 5" in. to .60-108... ft., Dia ... in. to ... ft.
 Casing height above land surface... 24" in., weight ... 2.82... lbs./ft. Wall thickness or gauge No. ... 258

TYPE OF SCREEN OR PERFORATION MATERIAL:
 1 Steel 3 Stainless steel 5 Fiberglass 7 PVC 10 Asbestos-cement
 2 Brass 4 Galvanized steel 6 Concrete tile 8 RMP (SR) 11 Other (specify)
 SCREEN OR PERFORATION OPENINGS ARE:
 1 Continuous slot 3 Mill slot 5 Gauzed wrapped 8 Saw cut 11 None (open hole)
 2 Louvered shutter 4 Key punched 6 Wire wrapped 9 Drilled holes
 7 Torch cut 10 Other (specify)

SCREEN-PERFORATED INTERVALS: From... 40... ft. to... 60... ft., From... ft. to... ft.
 From... 108... ft. to... 110... ft., From... ft. to... ft.
 GRAVEL PACK INTERVALS: From... 24... ft. to... 110... ft., From... ft. to... ft.
 From... ft. to... ft., From... ft. to... ft.

6 GROUT MATERIAL: 1 Neat cement 2 Cement grout 3 Bentonite 4 Other
 Grout Intervals: From... 4... ft. to... 24... ft., From... ft. to... ft., From... ft. to... ft.
 What is the nearest source of possible contamination:
 1 Septic tank 4 Lateral lines 7 Pit privy 10 Livestock pens 14 Abandoned water well
 2 Sewer lines 5 Cess pool 8 Sewage lagoon 11 Fuel storage 15 Oil well/Gas well
 3 Watertight sewer lines 6 Seepage pit 9 Feedyard 12 Fertilizer storage 16 Other (specify below)
 13 Insecticide storage
 Direction from well? east How many feet? 135'

FROM	TO	LITHOLOGIC LOG	FROM	TO	PLUGGING INTERVALS
0	2	Top Soil	69	90	Shale-Grey
2	26	Clay-Brown	90	93	Sandstone-Grey
26	27	Fine Sand-Brown	93	94	Shale-Grey
27	29	Clay-Brown	94	105	Limestone-Grey
29	30	Boulders			
30	42	Clay-Brown			
42	43	Boulders			
43	48	FS-CS-Med Gravel Brown-dirty			
48	52	Clay-Brown			
52	54	Limestone-Brown-Loose			
54	59	Limestone-Grey			
59	61	Shale-Grey			
61	64	Sandstone-Grey			
64	69	Limestone-Grey			

7 CONTRACTOR'S OR LANDOWNER'S CERTIFICATION: This water well was (1) constructed, (2) reconstructed, or (3) plugged under my jurisdiction and was completed on (mo/day/year) ... 11-22-91 ... and this record is true to the best of my knowledge and belief. Kansas Water Well Contractor's License No. ... 182 ... This Water Well Record was completed on (mo/day/yr) ... 12-6-91 ... under the business name of STRADER DRILLING CO., INC. by (signature) Dale Strader