

VBR

(5)

USE TYPEWRITER OR BALL POINT PEN-PRESS FIRMLY, PRINT CLEARLY.

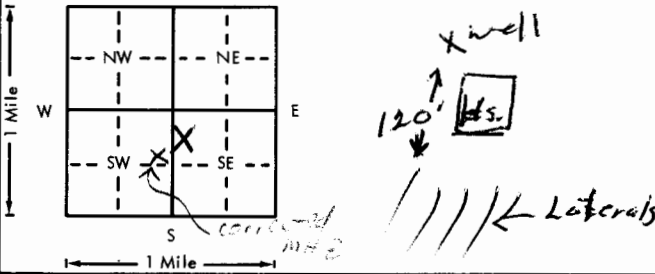
WATER WELL RECORD
KSA 82a-1201-1215

Kansas Department of Health and Environment-Division of Environment
(Water well Contractors)
Topeka, Kansas 66620

SE - NW - SW cad

1. Location of well: County Jefferson Fraction NW 1/4 SE 1/4 Section number 35 Township number T 8 S R 19 SW

2. Distance and direction from nearest town or city: 3/4 mi. S. Winchester 3. Owner of well: Charles Penner
R.R. or street: _____ City, state, zip code: Winchester, KS

4. Locate with "X" in section below: Sketch map: 

6. Bore hole dia. 8 in. Completion date 12-14-76
Well depth 120 ft.

7. Cable tool Rotary Driven Dug
 Hollow rod Jetted Bored Reverse rotary

8. Use: Domestic Public supply Industry
 Irrigation Air conditioning Stock
 Lawn Oil field water Other

9. Casing: Material PVC Height: Above or below
Threaded Welded Surface 24 in.
RMP PVC Glue 1 1/4 lbs./ft.
Dia. 5 in. to 120 ft. depth Wall Thickness: inches or
Dia. 5 in. to 120 ft. depth gage No. 274-258

10. Screen: Manufacturer's name Pumco
Type PVC Dia. 5"
Slot/gauze .080 Length 30
Set between 20 ft. and 40 ft.
60 ft. and 70 ft.
Gravel pack? Size range of material 4x1/8

11. Static water level: _____ mo./day/yr.
20 ft. below land surface Date 12-14-76

12. Pumping level below land surfaces:
_____ ft. after _____ hrs. pumping _____ g.p.m.
_____ ft. after _____ hrs. pumping _____ g.p.m.
Estimated maximum yield 3/4 _____ g.p.m.

13. Water sample submitted: _____ mo./day/yr.
Yes No Date _____

14. Well head completion: Capped
 Pitless adapter 24 Inches above grade

15. Well grouted?
With: Neat cement Bentonite Concrete
Depth: From 5 ft. to 15 ft.

16. Nearest source of possible contamination:
ft. 120 Direction S. Type laterals
Well disinfected upon completion? Yes No

17. Pump: Not installed
Manufacturer's name _____
Model number _____ HP _____ Volts _____
Length of drop pipe _____ ft. capacity _____ g.p.m.
Type:
 Submersible Turbine
 Jet Reciprocating
 Centrifugal Other

18. Elevation: 1095
1100
Topography: Hill Slope Upland Valley

19. Remarks: owner will pour slab around well

20. Water well contractor's certification:
This well was drilled under my jurisdiction and this report is true to the best of my knowledge and belief.
Business name Strader D&L Co Inc License No. 182
Address RT 1 Holton, KS
Signed Deke Daker Date 12-15-76
Authorized representative

Forward the white, blue and pink copies to the Department of Health and Environment

Form WWC-5

CR = 1080
75
S = 1080
75

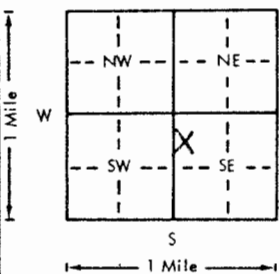
USE TYPEWRITER OR BALL POINT PEN-PRESS FIRMLY, PRINT CLEARLY.

WATER WELL RECORD
KSA 82a-1201-1215

Kansas Department of Health and Environment-Division of Environment
(Water well Contractors)
Topeka, Kansas 66620

?? not checked
27 - No elevation
no X on map

cad

1. Location of well: County: <u>Jefferson</u>		Fraction: <u>N 1/4 of 1/4</u> <u>SE 1/4</u>		Section number: <u>35</u>	Township number: <u>T 8 S R 19 E</u>	Range number: <u>19 E</u>
2. Distance and direction from nearest town or city: Street address of well location if in city: <u>3/4 mi. S. Winchester</u>				3. Owner of well: <u>Charles Pence</u> R.R. or street: City, state, zip code: <u>Winchester, KS</u>		
4. Locate with "X" in section below: Sketch map: 				6. Bore hole dia. <u>8</u> in. Completion date <u>12-14-76</u> Well depth <u>120</u> ft.		
5. Type and color of material				7. Cable tool <input checked="" type="checkbox"/> Rotary <input type="checkbox"/> Driven <input type="checkbox"/> Dug <input type="checkbox"/> Hollow rod <input type="checkbox"/> Jetted <input type="checkbox"/> Bored <input type="checkbox"/> Reverse rotary		
				8. Use: <input type="checkbox"/> Domestic <input type="checkbox"/> Public supply <input type="checkbox"/> Industry <input type="checkbox"/> Irrigation <input type="checkbox"/> Air conditioning <input type="checkbox"/> Stock <input type="checkbox"/> Lawn <input type="checkbox"/> Oil field water <input type="checkbox"/> Other		
				9. Casing: Material <u>PVC</u> Height: <u>Above</u> or below Threaded <input type="checkbox"/> Welded <input type="checkbox"/> Surface <u>24</u> in. RMP <input type="checkbox"/> PVC <u>4 in</u> Weight <u>2.58</u> lbs./ft. Dia. <u>5</u> in. to <u>120</u> ft. depth Wall Thickness: inches or Dia. <u>5</u> in. to <u>120</u> ft. depth gage No. <u>2774-258</u>		
				10. Screen: Manufacturer's name <u>Pumco</u> Type <u>PVC</u> Dia. <u>5"</u> Slot/gauze <u>.080</u> Length <u>30</u> Set between <u>20</u> ft. and <u>40</u> ft. <u>60</u> ft. and <u>70</u> ft. Gravel pack? <input checked="" type="checkbox"/> Size range of material <u>4x1/2"</u>		
				11. Static water level: <u>20</u> ft. below land surface Date <u>12-14-76</u> mo./day/yr.		
				12. Pumping level below land surfaces: <u> </u> ft. after <u> </u> hrs. pumping <u> </u> g.p.m. <u> </u> ft. after <u> </u> hrs. pumping <u> </u> g.p.m. Estimated maximum yield <u>3/4</u> g.p.m.		
				13. Water sample submitted: <u> </u> mo./day/yr. Yes <input checked="" type="checkbox"/> No <input type="checkbox"/> Date <u> </u>		
				14. Well head completion: <u> capped</u> <u> </u> Pitless adapter <u>24</u> inches above grade		
				15. Well grouted? <input checked="" type="checkbox"/> With: <input checked="" type="checkbox"/> Neat cement <input type="checkbox"/> Bentonite <input type="checkbox"/> Concrete Depth: From <u>5</u> ft. to <u>15</u> ft.		
				16. Nearest source of possible contamination: ft. <u>120</u> Direction <u>S</u> Type <u>Lifers</u> Well disinfected upon completion? <input checked="" type="checkbox"/> Yes <input type="checkbox"/> No		
				17. Pump: <input checked="" type="checkbox"/> Not installed Manufacturer's name <u> </u> Model number <u> </u> HP <u> </u> Volts <u> </u> Length of drop pipe <u> </u> ft. Capacity <u> </u> g.p.m. Type: <input type="checkbox"/> Submersible <input type="checkbox"/> Turbine <input type="checkbox"/> Jet <input type="checkbox"/> Reciprocating <input type="checkbox"/> Centrifugal <input type="checkbox"/> Other		
				20. Water well contractor's certification: This well was drilled under my jurisdiction and this report is true to the best of my knowledge and belief. <u>Straider Drilling Co Inc</u> License No. <u>182</u> Business name <u> </u> Address <u>Rt 1 Haltem, KS</u> Signed <u>Neil Haltem</u> Date <u>12-15-76</u> Authorized representative		
18. Elevation <u>1098'</u> Topography: <input type="checkbox"/> Hill <input checked="" type="checkbox"/> Slope <input type="checkbox"/> Upland <input type="checkbox"/> Valley		19. Remarks: <u>owner will pour slab around well</u>				

Forward the white, blue and pink copies to the Department of Health and Environment

Form WWC-5