


1 LOCATION OF WATER WELL: Fraction NW 1/4 NW 1/4 NW 1/4 Section Number 13 Township Number T 8 S Range Number R 19 EW  
 County: Jefferson

Distance and direction from nearest town or city street address of well if located within city?  
 1/2 mi East 2 1/2 North of Winchester

2 WATER WELL OWNER: John Brown  
 RR#, St. Address, Box #: 12109 Parallel Parkway Board of Agriculture, Division of Water Resources  
 City, State, ZIP Code: Kansas City, KS 66109 Application Number:

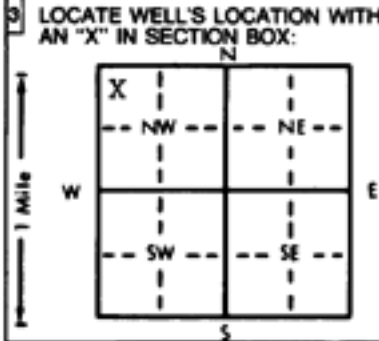

4 DEPTH OF COMPLETED WELL... 100' ft. ELEVATION:  
 Depth(s) Groundwater Encountered 1. .... ft. 2. .... ft. 3. .... ft.  
 WELL'S STATIC WATER LEVEL ... 46' ft. below land surface measured on mo/day/yr 05/05/00  
 Pump test data: Well water was .... ft. after .... hours pumping .... gpm  
 Est. Yield ... 3 ... gpm; Well water was .... ft. after .... hours pumping .... gpm  
 Bore Hole Diameter ... 12" in. to .... ft., and .... in. to .... ft.  
 WELL WATER TO BE USED AS: 5 Public water supply 8 Air conditioning 11 Injection well  
 1 Domestic 3 Feedlot 6 Oil field water supply 9 Dewatering 12 Other (Specify below)  
 2 Irrigation 4 Industrial 7 Lawn and garden only 10 Monitoring well  
 Was a chemical/bacteriological sample submitted to Department? Yes.....No...X.....; If yes, mo/day/yr sample was submitted  
 Water Well Disinfected? Yes X No

5 TYPE OF BLANK CASING USED:  
 1 Steel 3 RMP (SR) 5 Wrought iron 8 Concrete tile CASING JOINTS: Glued X Clamped  
 2 PVC 4 ABS 6 Asbestos-Cement 9 Other (specify below) Welded  
 7 Fiberglass Threaded  
 Blank casing diameter ... 5" in. to ... 0-45' ft., Dia ... 5" in. to ... 65-98' ft., Dia ... in. to ... ft.  
 Casing height above land surface ... 24" in., weight ... 2.82 lbs./ft. Wall thickness or gauge No. ... 258  
 TYPE OF SCREEN OR PERFORATION MATERIAL:  
 1 Steel 3 Stainless steel 5 Fiberglass 7 PVC 10 Asbestos-cement  
 2 Brass 4 Galvanized steel 6 Concrete tile 8 RMP (SR) 11 Other (specify)  
 9 ABS 12 None used (open hole)  
 SCREEN OR PERFORATION OPENINGS ARE:  
 1 Continuous slot 3 Mill slot 5 Gauzed wrapped 8 Saw cut 11 None (open hole)  
 2 Louvered shutter 4 Key punched 6 Wire wrapped 9 Drilled holes  
 7 Torch cut 10 Other (specify)  
 SCREEN-PERFORATED INTERVALS: From ... 45' ft. to ... 65' ft., From ... ft. to ... ft.  
 From ... 98' ft. to ... 100' ft., From ... ft. to ... ft.  
 GRAVEL PACK INTERVALS: From ... 24' ft. to ... 100' ft., From ... ft. to ... ft.  
 From ... ft. to ... ft., From ... ft. to ... ft.

6 GROUT MATERIAL: 1 Neat cement 2 Cement grout 3 Bentonite 4 Other  
 Grout intervals: From ... 4' ft. to ... 24' ft., From ... ft. to ... ft., From ... ft. to ... ft.  
 What is the nearest source of possible contamination:  
 1 Septic tank 4 Lateral lines 7 Pit privy 10 Livestock pens 14 Abandoned water well  
 2 Sewer lines 5 Cess pool 8 Sewage lagoon 11 Fuel storage 15 Oil well/Gas well  
 3 Watertight sewer lines 6 Seepage pit 9 Feedyard 12 Fertilizer storage 16 Other (specify below)  
 13 Insecticide storage  
 Direction from well? NorthEast How many feet? 300'

FROM	TO	LITHOLOGIC LOG	FROM	TO	PLUGGING INTERVALS
0	3	Top soil			
3	45	Clay-brown			
45	49	FS-brown			
49	50	Clay-brown			
50	55	FS-brown			
55	61	IS-grey			
61	71	Shale-grey			
71	78	IS-grey			
78	92	Shale-grey			
92	94	IS-grey			
94	100	Shale-grey			

7 CONTRACTOR'S OR LANDOWNER'S CERTIFICATION: This water well was (1) constructed, (2) reconstructed, or (3) plugged under my jurisdiction and was completed on (mo/day/year) 05/05/00 and this record is true to the best of my knowledge and belief. Kansas Water Well Contractor's License No. 182 This Water Well Record was completed on (mo/day/yr) 5-31-00 under the business name of Strader Drilling Co, Inc. by (signature) Dale Strader

INSTRUCTIONS: Use typewriter or ball point pen. PLEASE PRESS FIRMLY and PRINT clearly. Please fill in blanks, underline or circle the correct answers. Send top three copies to Kansas Department of Health and Environment, Bureau of Water, Topeka, Kansas 66620-0001. Telephone: 913-296-5545. Send one to WATER WELL OWNER and retain one for your records.