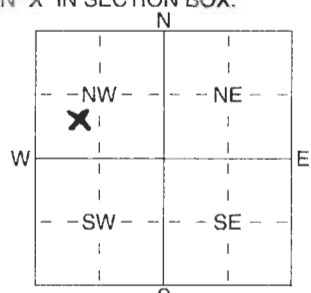


1 LOCATION OF WATER WELL: Fraction NE 1/4 SW 1/4 NW 1/4 Section Number 36 Township Number T 8 S Range Number R 19 E
 County: Jefferson

Distance and direction from nearest town or city street address of well if located within city?
.7 East and .7 South of Winchester

2 WATER WELL OWNER: ALVIN W. Barnhardt
 RR#, St. Address, Box # : Box 16 Board of Agriculture, Division of Water Resources
 City, State, ZIP Code : Winchester, KS, 66097 Application Number:

3 LOCATE WELL'S LOCATION WITH AN "X" IN SECTION BOX:  DEPTH OF COMPLETED WELL 100 ft. ELEVATION:
 Depth(s) Groundwater Encountered 1 50-63 ft. 2 ft. 3 ft.
 WELL'S STATIC WATER LEVEL ft. below land surface measured on mo/day/yr
 Pump test data: Well water was ft. after hours pumping gpm
 Est. Yield 1 gpm: Well water was ft. after hours pumping gpm
 WELL WATER TO BE USED AS: 5 Public water supply 8 Air conditioning 11 Injection well
 1 Domestic 3 Feedlot 6 Oil field water supply 9 Dewatering 12 Other (Specify below)
 2 Irrigation 4 Industrial 7 Domestic (lawn & garden) 10 Monitoring well
 Was a chemical/bacteriological sample submitted to Department? Yes No X; If yes, mo/day/yr sample was submitted
 Water Well Disinfected? Yes X No

5 TYPE OF BLANK CASING USED: 1 Steel 3 RMP (SR) 5 Wrought iron 8 Concrete tile CASING JOINTS: Glued X Clamped
 2 PVC 4 ABS 6 Asbestos-Cement 9 Other (specify below) Welded
 Blank casing diameter 5 in. to 53 ft. Dia 5 in. to 63-100 ft. Dia in. to ft.
 Casing height above land surface 18 in., weight SDR 24 lbs./ft. Wall thickness or gauge No.
 TYPE OF SCREEN OR PERFORATION MATERIAL: PVC 10 Asbestos-Cement
 1 Steel 3 Stainless Steel 5 Fiberglass 8 RMP (SR) 11 Other (Specify)
 2 Brass 4 Galvanized Steel 6 Concrete tile 9 ABS 12 None used (open hole)
 SCREEN OR PERFORATION OPENINGS ARE: 5 Gauzed wrapped 8 Saw cut 11 None (open hole)
 1 Continuous slot 3 Mill slot 6 Wire wrapped 9 Drilled holes
 2 Louvered shutter 4 Key punched 7 Torch cut 10 Other (specify) ft.
 SCREEN-PERFORATED INTERVALS: From 53 ft. to 63 ft. From ft. to ft.
 GRAVEL PACK INTERVALS: From 100 ft. to 22 ft. From ft. to ft.

6 GROUT MATERIAL: 1 Neat cement 2 Cement grout 3 Bentonite 4 Other
 Grout Intervals: From 22 ft. to 0 ft. From ft. to ft. From ft. to ft.
 What is the nearest source of possible contamination: None at Time of Drilling 10 Livestock pens 14 Abandoned water well
 1 Septic tank 4 Lateral lines 7 Pit privy Drilling 11 Fuel storage 15 Oil well/Gas well
 2 Sewer lines 5 Cess pool 8 Sewage lagoon 12 Fertilizer storage 16 Other (specify below)
 3 Watertight sewer lines 6 Seepage pit 9 Feedyard 13 Insecticide storage
 Direction from well? How many feet?

FROM	TO	LITHOLOGIC LOG	FROM	TO	PLUGGING INTERVALS
0	1	Soil			
1	34	Clay			
34	63	yellow sandstone			
63	66	Limestone			
66	70	shale			
70	72	Limestone			
72	100	shale			

7 CONTRACTOR'S OR LANDOWNER'S CERTIFICATION: This water well was (1) constructed, (2) reconstructed, or (3) plugged under my jurisdiction and was completed on (mo/day/year) 8-6-04 and this record is true to the best of my knowledge and belief. Kansas Water Well Contractor's Licence No 511 This Water Well Record was completed on (mo/day/yr) 8-7-04 under the business name of Evans Energy Dev Inc. by signature [Signature]