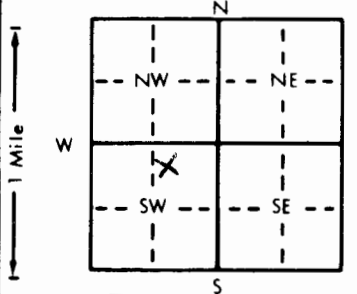


1 LOCATION OF WATER WELL: County: <b>JEFFERSON</b>	Fraction <b>NW 1/4 NE 1/4 SW 1/4</b>	Section Number <b>26</b>	Township Number <b>T 8 S</b>	Range Number <b>R 19 EW</b>
---	---	-----------------------------	---------------------------------	--------------------------------

Distance and direction from nearest town or city street address of well if located within city?  
**Third & Grass Hopper Winchester, Ks**


2 WATER WELL OWNER: RR#, St. Address, Box # : <b>DAVE CLAXTON</b> <b>17921 142ND</b> City, State, ZIP Code : <b>WINCHESTER KS 66097</b>	Board of Agriculture, Division of Water Resources Application Number:
--	--

3 LOCATE WELL'S LOCATION WITH AN "X" IN SECTION BOX: 	4 DEPTH OF COMPLETED WELL: <b>25</b> ft. ELEVATION: Depth(s) Groundwater Encountered <b>1</b> ft. 2. ft. 3. ft. WELL'S STATIC WATER LEVEL <b>0</b> ft. below land surface measured on mo/day/yr Pump test data: Well water was _____ ft. after _____ hours pumping _____ gpm Est. Yield _____ gpm: Well water was _____ ft. after _____ hours pumping _____ gpm Bore Hole Diameter: <b>7 1/4</b> in. to <b>25</b> ft., and _____ in. to _____ ft. WELL WATER TO BE USED AS: 5 Public water supply 8 Air conditioning 11 Injection well 1 Domestic 3 Feedlot 6 Oil field water supply 9 Dewatering 12 Other (Specify below) 2 Irrigation 4 Industrial 7 Lawn and garden only <input checked="" type="checkbox"/> Monitoring well Was a chemical/bacteriological sample submitted to Department? Yes _____ No _____; If yes, mo/day/yr sample was submitted _____ Water Well Disinfected? Yes _____ No _____
--	---

5 TYPE OF BLANK CASING USED: 1 Steel 3 RMP (SR) 5 Wrought iron 8 Concrete tile 2 PVC 4 ABS 6 Asbestos-Cement 9 Other (specify below) Blank casing diameter <b>2</b> in. to <b>15</b> ft., Dia _____ in. to _____ ft., Dia _____ in. to _____ ft. Casing height above land surface: <b>0</b> in., weight <b>Sched 40</b> lbs./ft. Wall thickness or gauge No. _____ TYPE OF SCREEN OR PERFORATION MATERIAL: 1 Steel 3 Stainless steel 5 Fiberglass 8 RMP (SR) 2 Brass 4 Galvanized steel 6 Concrete tile 9 ABS SCREEN OR PERFORATION OPENINGS ARE: 1 Continuous slot 2 Mill slot 5 Gauzed wrapped 8 Saw cut 11 None (open hole) 2 Louvered shutter 4 Key punched 6 Wire wrapped 9 Drilled holes 3 Torch cut 10 Other (specify) _____
--

6 GROUT MATERIAL: 1 Neat cement 2 Cement grout 3 Bentonite 4 Other Grout Intervals: From <b>10</b> ft. to <b>-05</b> ft., From <b>13</b> ft. to <b>10</b> ft., From _____ ft. to _____ ft. What is the nearest source of possible contamination: 1 Septic tank 4 Lateral lines 7 Pit privy 10 Livestock pens 14 Abandoned water well 2 Sewer lines 5 Cess pool 8 Sewage lagoon 11 Fuel storage 15 Oil well/Gas well 3 Watertight sewer lines 6 Seepage pit 9 Feedyard 12 Fertilizer storage 16 Other (specify below) 13 Insecticide storage Direction from well? <b>WEST</b> How many feet? <b>40</b>
--

FROM	TO	LITHOLOGIC LOG	FROM	TO	PLUGGING INTERVALS
0	6"	Asphalt			
6"	10	Brn Silty Clay			
10	20	Wn Oliv Silty Clay			
20	25	Tan Silty Clay			

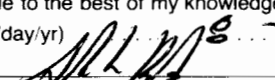7 CONTRACTOR'S OR LANDOWNER'S CERTIFICATION: This water well was <input checked="" type="checkbox"/> constructed, (2) reconstructed, or (3) plugged under my jurisdiction and was completed on (mo/day/year) <b>8-12-98</b> and this record is true to the best of my knowledge and belief. Kansas Water Well Contractor's License No. <b>575</b> This Water Well Record was completed on (mo/day/yr) <b>8-28-98</b> under the business name of <b>KURTZ ENVIRONMENTAL SERVICE</b> by (signature) 
---

OFFICE USE ONLY