


1 LOCATION OF WATER WELL: County: Jefferson Fraction NW 1/4 NE 1/4 SW 1/4 Section Number 26 Township Number T 8 S Range Number R 19

Distance and direction from nearest town or city street address of well if located within city?

300 Grasshopper Street, Winchester, Kansas

2 WATER WELL OWNER: Dave Claxton RR#, St. Address, Box #: RR 1 City, State, ZIP Code: Winchester, Kansas 66097 Board of Agriculture, Division of Water Resources Application Number:

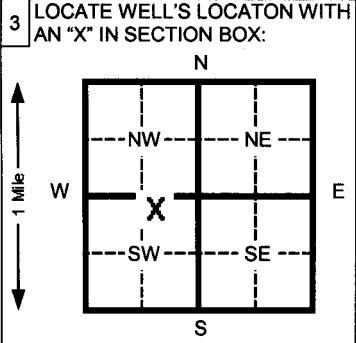

3 LOCATE WELL'S LOCATION WITH AN 'X' IN SECTION BOX: 4 DEPTH OF COMPLETED WELL 25.0 ft. ELEVATION: Depth(s) Groundwater Encountered 1 19.0 ft. 2 ft. 3 ft. WELL'S STATIC WATER LEVEL 13.28 ft. below land surface measured on mo/day/yr 03/14/07 Pump test data: Well water was ft. after hours pumping gpm Est. Yield NA gpm: Well water was ft. after hours pumping gpm Bore Hole Diameter 8.5 in. to 25.0 ft. and in. to ft. WELL WATER TO BE USED AS: 5 Public water supply 8 Air conditioning 11 Injection well 1 Domestic 3 Feed lot 6 Oil field water supply 9 Dewatering 12 Other (Specify below) 2 Irrigation 4 Industrial 7 Lawn and garden (domestic) 10 Monitoring well Was a chemical/bacteriological sample submitted to Department? Yes No X If yes, mo/day/yr sample was submitted Water Well Disinfected? Yes No X

5 TYPE OF BLANK CASING USED: 1 Steel 2 PVC 3 RMP (SR) 4 ABS 5 Wrought Iron 6 Asbestos-Cement 7 Fiberglass 8 Concrete tile 9 Other (specify below) CASING JOINTS: Glued Clamped Welded Threaded X Blank casing diameter 2.375 in. to 10.0 ft., Dia in. to ft., Dia in. to ft. Casing height above land surface Flush Mount in., weight lbs./ft. Wall thickness or gauge No. Schedule 40 TYPE OF SCREEN OR PERFORATION MATERIAL: 1 Steel 2 Brass 3 Stainless steel 4 Galvanized steel 5 Fiberglass 6 Concrete tile 7 PVC 8 RMP (SR) 9 ABS 10 Asbestos-cement 11 Other (specify) 12 None used (open hole) SCREEN OR PERFORATION OPENINGS ARE: 1 Continuous slot 2 Louvered shutter 3 Mill slot 4 Key punched 5 Gauzed wrapped 6 Wire wrapped 7 Torch cut 8 Saw cut 9 Drilled holes 10 Other (specify) 11 None (open hole) SCREEN-PERFORATED INTERVALS: From 25.0 ft. to 10.0 ft. GRAVEL PACK INTERVALS: From 25.0 ft. to 8.0 ft.

6 GROUT MATERIAL: 1 Neat cement 2 Cement grout 3 Bentonite 4 Other Grout Intervals From 0.0 ft. to 1.0 ft. From 1.0 ft. to 8.0 ft. From ft. to ft. What is the nearest source of possible contamination: 1 Septic tank 2 Sewer lines 3 Watertight sewer lines 4 Lateral lines 5 Cess pool 6 Seepage pit 7 Pit privy 8 Sewage lagoon 9 Feedyard 10 Livestock pens 11 Fuel storage (former) 12 Fertilizer storage 13 Insecticide storage 14 Abandoned water well 15 Oil well/ Gas well 16 Other (specify below) Direction from well? West How many feet? 175

FROM	TO	CODE	LITHOLOGIC LOG
0.0	0.5		Topsoil
0.5	7.5		Brown to dark brown very silty clay, very firm, moist
7.5	12.0		Red brown very silty clay, very firm, moist
12.0	15.0		Gray brown-light gray brown very silty clay, very firm, moist, trace hydrocarbon odor
15.0	17.0		Light gray very silty clay, very firm, moist, trace hydrocarbon odor
17.0	25.0		Olive green-red brown very silty clay, 1/4" sub-rounded limestone fragments, very firm-plastic, moist-very moist, trace hydrocarbon odor
Flush-mount well completion waiver existent for site.			

7 CONTRACTOR'S OR LANDOWNER'S CERTIFICATION: This water well was 1 constructed, 2 reconstructed, or 3 plugged under my jurisdiction and was completed on (mo/day/yr) 03/12/07 and this record is true to the best of my knowledge and belief. Kansas Water Well Contractor's License No. 692 This Water Well Record was completed on (mo/day/yr) 03/15/07 under the business name of Quad State Services, Inc. by (signature)

INSTRUCTIONS: Please fill in blanks and circle the correct answers. Send three copies to Kansas Department of Health and Environment, Bureau of Water, 1000 S W Jackson St., Ste. 420, Topeka, Kansas 66612-1367. Telephone: 913-296-5545. Send one to WATER WELL OWNER and retain one for your records.

OFFICE USE ONLY

T R

SEC