


WATER WELL RECORD Form WWC-5 KSA 82a-1212

1 LOCATION OF WATER WELL: County: CLAY Fraction NW 1/4 NW 1/4 NW 1/4 Section Number 12 Township Number T 8 S Range Number R 2 E/W

Distance and direction from nearest town or city street address of well if located within city? 1206 18TH ROAD, CLAY CENTER, KS.

2 WATER WELL OWNER: ROBSON OIL CO. RR#, St. Address, Box #: 101 South Cedar St. City, State, ZIP Code: ABILENE, KS. 67410 Board of Agriculture, Division of Water Resources Application Number: NA

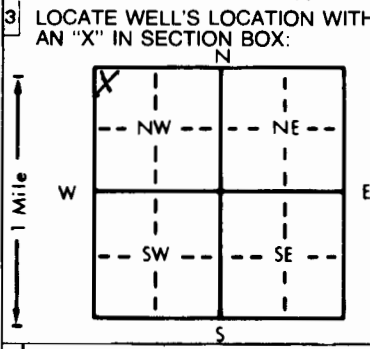

3 LOCATE WELL'S LOCATION WITH AN 'X' IN SECTION BOX: 4 DEPTH OF COMPLETED WELL: 38.0 ft. ELEVATION: WELL'S STATIC WATER LEVEL: 27.3 ft. below land surface measured on mo/day/yr 4/15/97

5 TYPE OF BLANK CASING USED: 1 Steel 2 PVC 3 RMP (SR) 4 ABS 5 Wrought iron 6 Asbestos-Cement 7 Fiberglass 8 Concrete tile 9 Other (specify below) CASING JOINTS: Glued Clamped Welded Threaded X

6 GROUT MATERIAL: 1 Neat cement 2 Cement grout 3 Bentonite 4 Other Grout Intervals: 2 From 0 ft. to 18 ft. 3 From 18 ft. to 20 ft.

Table with columns: FROM, TO, LITHOLOGIC LOG, FROM, TO, PLUGGING INTERVALS. Rows include: 0 to 26 CLAY LEAN, 26 to 38 SAND, FINE TO MED., 38 TOTAL DEPTH.

7 CONTRACTOR'S OR LANDOWNER'S CERTIFICATION: This water well was (1) constructed, (2) reconstructed, or (3) plugged under my jurisdiction and was completed on (mo/day/year) 4/10/97 and this record is true to the best of my knowledge and belief. Kansas Water Well Contractor's License No. 585 This Water Well Record was completed on (mo/day/yr) 4/29/97 under the business name of Associated Environmental, Inc. by (signature)