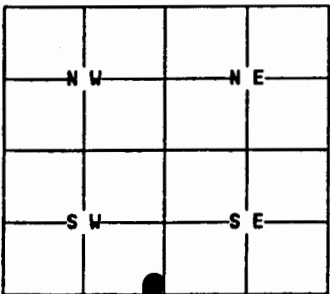


1 LOCATION OF WATER WELL:		Fraction	Section Number	Township Number	Range Number																								
County: Clay		SE1/4 SE1/4 SW1/4	1	8S	2E																								
Distance and direction from nearest town or city street address of well if located within city? 2,330 feet west of Clay Center west city limits.																													
2 WATER WELL OWNER: Kansas Department of Transportation																													
RR#, St. Address, Box #: P.O. Box 330 City, State, ZIP Code : Clay Center, KS 67432																													
Board of Agriculture, Division of Water Resources Application Number:																													
3 MARK WELL'S LOCATION WITH AN "X" IN SECTION BOX:		4 DEPTH OF WELL.....20.....ft.																											
N 		WELL'S STATIC WATER LEVEL.....ft. WELL WAS USED AS: 1 Domestic 5 Public Water Supply 9 Dewatering 2 Irrigation 6 Oil Field Water Supply 10 Monitoring Well 3 Feedlot 7 Lawn and Garden Only 11 Injection Well 4 Industrial 8 Air Conditioning 12 Other...Class.V.Drain																											
Was a chemical/bacteriological sample submitted to Department? Yes....No...X. If yes, mo/day/yr sample was submitted..... Water Well Disinfected: Yes..... No...X																													
5 TYPE OF BLANK CASING USED: 1 Steel 3 RMP (SR) 5 Wrought 7 Fiberglass 9 Other (specify below) 2 PVC 4 ABS 6 Asbestos-Cement 8 Concrete Tile Reinforced Concrete Pipe..... Blank casing diameter.....36.....in. Was casing pulled? Yes....X No..... If yes, how much.....16' Casing height above or (below) land surface.....in.																													
6 GROUT PLUG MATERIAL: 1 Neat cement 2 Cement grout 3 Bentonite 4 Other Flowable Fill Concrete Grout Plug Intervals: From.....5.....ft. to.....4.....ft., From.....ft. toft., From..... to.....ft. What is the nearest source of possible contamination: 1 Septic tank 6 Seepage pit 11 Fuel storage 16 Other (specify below) 2 Sewer lines 7 Pit privy 12 Fertilizer storage Road Ditch..... 3 Watertight sewer lines 8 Sewage lagoon 13 Insecticide storage 4 Lateral lines 9 Feedyard 14 Abandoned water well 5 Cess Pool 10 Livestock pens 15 Oil well/Gas well Direction from well? How many feet?																													
<table border="1"><thead><tr><th>FROM</th><th>TO</th><th>PLUGGING MATERIALS</th></tr></thead><tbody><tr><td>16</td><td>15</td><td>Flowable Fill</td></tr><tr><td>15</td><td>0</td><td>Compacted Clay Soil</td></tr><tr><td> </td><td> </td><td> </td></tr><tr><td> </td><td> </td><td> </td></tr><tr><td> </td><td> </td><td> </td></tr><tr><td> </td><td> </td><td> </td></tr><tr><td> </td><td> </td><td> </td></tr></tbody></table>						FROM	TO	PLUGGING MATERIALS	16	15	Flowable Fill	15	0	Compacted Clay Soil															
FROM	TO	PLUGGING MATERIALS																											
16	15	Flowable Fill																											
15	0	Compacted Clay Soil																											
7 CONTRACTOR'S OR LANDOWNER'S CERTIFICATION: This water well was plugged under my jurisdiction and was completed on (mo/day/year).....09/13/99..... and this record is true to the best of my knowledge and belief. Kansas Water Well Contractor's License No. This Water Well Record was completed on (mo/day/year) under the business name of KDOT, Dist. 2, Area 1 by (signature) ..N. Hershberger.. For Dale E. Hershberger, Area Engineer																													
INSTRUCTIONS: Use typewriter or ball point pen. Please press firmly and print clearly. Please fill in blanks, underline or circle the correct answers. Send top three copies to Kansas Department of Health and Environment, Bureau of Water, Topeka, Kansas 66620-0001. Telephone: 785/296-3565. Send one to Water Well Owner and retain one for your records.																													