


W206-13

1 LOCATION OF WATER WELL: Fraction NW 1/4 NW 1/4 SW 1/4 Section Number 28 Township Number T 8 S Range Number R 2 E  
 County: CLAY

Distance and direction from nearest town or city street address of well if located within city?  
FROM CLAY CENTER: 4 MILES SOUTH, 5 WEST, 1/2 NORTH (1468 INDIAN RD)

2 WATER WELL OWNER: Don Wagner  
 RR#, St. Address, Box # : 1468 INDIAN RD Board of Agriculture, Division of Water Resources  
 City, State, ZIP Code : CLAY CENTER, KS. Application Number: \_\_\_\_\_

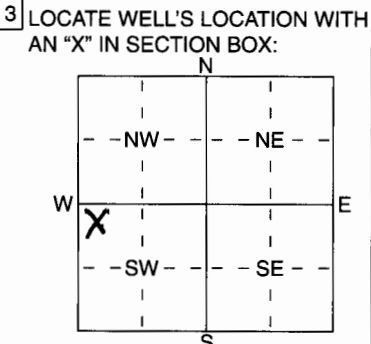

4 DEPTH OF COMPLETED WELL 115 ft. ELEVATION: \_\_\_\_\_  
 Depth(s) Groundwater Encountered 1 83 ft. 2 \_\_\_\_\_ ft. 3 \_\_\_\_\_ ft.  
 WELL'S STATIC WATER LEVEL 52 ft. below land surface measured on mo/day/yr 6/16/04  
 Pump test data: Well water was \_\_\_\_\_ ft. after \_\_\_\_\_ hours pumping \_\_\_\_\_ gpm  
 Est. Yield 50 gpm: Well water was \_\_\_\_\_ ft. after \_\_\_\_\_ hours pumping \_\_\_\_\_ gpm  
 WELL WATER TO BE USED AS: 5 Public water supply 8 Air conditioning 11 Injection well  
Domestic 3 Feedlot 6 Oil field water supply 9 Dewatering 12 Other (Specify below)  
 2 Irrigation 4 Industrial 7 Domestic (lawn & garden) 10 Monitoring well \_\_\_\_\_  
 Was a chemical/bacteriological sample submitted to Department? Yes \_\_\_\_\_ No X; If yes, mo/day/yr sample was submitted  
 Water Well Disinfected? Yes \_\_\_\_\_ No X

5 TYPE OF BLANK CASING USED: 1 Steel 2 PVC 3 RMP (SR) 4 ABS 5 Wrought iron 6 Asbestos-Cement 7 Fiberglass 8 Concrete tile 9 Other (specify below) CASING JOINTS: Glued X Clamped \_\_\_\_\_  
 Welded \_\_\_\_\_ Threaded \_\_\_\_\_  
 Blank casing diameter 5 in. to 7.5 ft. Dia 5 in. to 10.5 ft. Dia \_\_\_\_\_ in. to \_\_\_\_\_ ft.  
 Casing height above land surface 24 in., weight \_\_\_\_\_ lbs./ft. Wall thickness or gauge No. SDK 26  
 TYPE OF SCREEN OR PERFORATION MATERIAL: 1 Steel 2 Brass 3 Stainless Steel 4 Galvanized Steel 5 Fiberglass 6 Concrete tile PVC 8 RMP (SR) 9 ABS 10 Asbestos-Cement 11 Other (Specify) \_\_\_\_\_ 12 None used (open hole)  
 SCREEN OR PERFORATION OPENINGS ARE: 1 Continuous slot 2 Louvered shutter 3 Mill slot 4 Key punched 5 Gauzed wrapped 6 Wire wrapped 7 Torch cut 8 Saw cut 9 Drilled holes 10 Other (specify) \_\_\_\_\_ 11 None (open hole) \_\_\_\_\_ ft.  
 SCREEN-PERFORATED INTERVALS: From 7.5 ft. to 8.5 ft. From \_\_\_\_\_ ft. to \_\_\_\_\_ ft.  
 From 10.5 ft. to 11.5 ft. From \_\_\_\_\_ ft. to \_\_\_\_\_ ft.  
 GRAVEL PACK INTERVALS: From 2.5 ft. to 11.5 ft. From \_\_\_\_\_ ft. to \_\_\_\_\_ ft.  
 From \_\_\_\_\_ ft. to \_\_\_\_\_ ft. From \_\_\_\_\_ ft. to \_\_\_\_\_ ft.

6 GROUT MATERIAL: 1 Neat cement 2 Cement grout  Bentonite  4 Other \_\_\_\_\_  
 Grout Intervals: From 3 ft. to 2.5 ft. From \_\_\_\_\_ ft. to \_\_\_\_\_ ft. From \_\_\_\_\_ ft. to \_\_\_\_\_ ft.  
 What is the nearest source of possible contamination: 1 Septic tank 2 Sewer lines 3 Watertight sewer lines 4 Lateral lines 5 Cess pool 6 Seepage pit 7 Pit privy 8 Sewage lagoon 9 Feedyard 10 Livestock pens 11 Fuel storage 12 Fertilizer storage 13 Insecticide storage 14 Abandoned water well 15 Oil well/Gas well 16 Other (specify below) \_\_\_\_\_  
HOUSE  
 Direction from well? SOUTH EAST How many feet? 65

FROM	TO	LITHOLOGIC LOG	FROM	TO	PLUGGING INTERVALS
0	23	CLAY PAN			
23	29	SANDY CLAY			
29	77	SHALE, TAN TO GRAY			
77	83	LIMESTONE, FRAGMENTED, COBBLES (H2O)			
83	96	SHALE GRAY			
96	98	LIMESTONE			
98	115	SHALE, GRAY			

7 CONTRACTOR'S OR LANDOWNER'S CERTIFICATION: This water well was (1) constructed, (2) reconstructed, or (3) plugged under my jurisdiction and was completed on (mo/day/year) 6/16/04 and this record is true to the best of my knowledge and belief. Kansas Water Well Contractor's Licence No 585 This Water Well Record was completed on (mo/day/yr) 6/23/04 under the business name of ASSOCIATED RAINBOW WARRIOR PAL by signature [Signature]