

USE TYPEWRITER OR BALL POINT PEN-PRESS FIRMLY, PRINT CLEARLY.

8 2E 13 5E 5W T R EW sec 1/4 1/4 1/4 No.

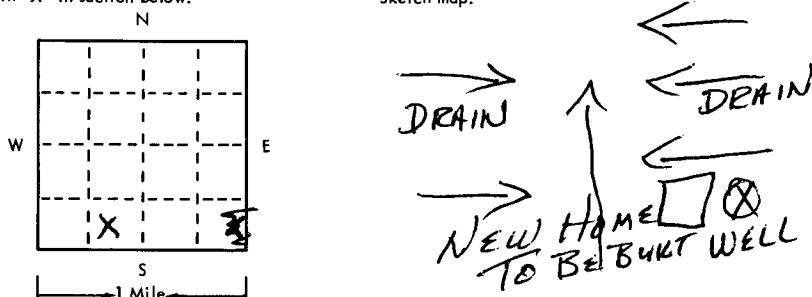
WATER WELL RECORD KSA 82a-1201-1215

Kansas State Dept. Of Health (Water Well Contractors) Forbes-Bldg. 740 Topeka, Kansas 66620

SE 1/4

1 Location of well: County CLAY Township name CLAY Fraction SE 1/4 of SW 1/4 Section number 13 Town number T 8 S Range number R 2 E

Distance and direction from nearest town or city: 2 5 1 1/2 W Street address of well location if in city: CLAY CENTER 3 Owner of well: GLEN CARLSON Address: CLAY CENTER, KANS

Locate with "X" in section below: Sketch map: 

4 Well depth: 80 ft. Date of completion 10/11/75 Well diameter 8 in.

5 Cable tool Rotary Driven Dug Hollow rod Jetted Bored Reverse rotary

6 Use: Domestic Public supply Industry Irrigation Air conditioning Commercial Test well

7 Casing: Material PVC Height: above below Threading: Threaded Welded Surface 1 1/2 in. Diam. 5 in. to 80 ft. depth Drive shoe? Yes No

8 Screen: Manufacturer CERTAIN TRED Type SLOTTED PVC Dia. 5 Slot/gauze 1/16" Length 20' Set between 80 ft. and 60 ft. Fittings: Grovel pack Yes No Size range of material

9 Static water level: 50 ft. below land surface Date 10/11/75

10 Pumping level below land surfaces: NA ft. after NA hrs. pumping NA g.p.m. NA ft. after NA hrs. pumping NA g.p.m. Estimated maximum yield 15 g.p.m.

11 Water sample submitted: Yes No Date

12 Well head completion: Pitless adapter Inches above grade

13 Well grouted? Yes No Neat cement Bentonite Depth: From 3 ft. to 13 ft.

14 Nearest source of possible contamination: ft. 1000 Direction NORTH Type LOTS Well disinfected upon completion? Yes No

15 Pump: Not installed Manufacturer's name Model number HP Volts Length of drop pipe ft. capacity g.p.m. Type: Submersible Turbine Jet Reciprocating Centrifugal Other

16 Remarks: elevation Topography: Hill Slope Upland Valley

17 Water well contractor's certification: This well was drilled under my jurisdiction and this report is true to the best of my knowledge and belief. GEO COX + SONS INC 358 Business name License No. Address CLAYTON, KANSAS Signed Glen Carlson Date 10/11/75 Authorized representative

8 2E 13 5E 5W