


1 LOCATION OF WATER WELL: Fraction NE 1/4 NW 1/4 SE 1/4 Section Number 29 Township Number T 8 S Range Number R 20

Distance and direction from nearest town or city street address of well if located within city? 3 miles east of Winchester

2 WATER WELL OWNER: Jim Baker
 RR#, St. Address, Box #: Rt. 1 Box 64B Board of Agriculture, Division of Water Resources
 City, State, ZIP Code: Winchester, KS 66097 Application Number:

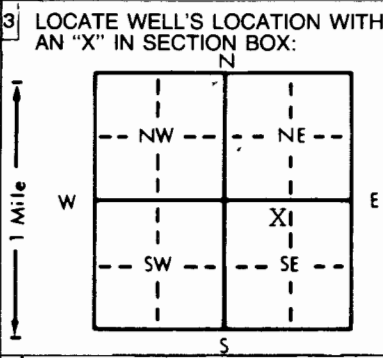

4 DEPTH OF COMPLETED WELL: 58' ft. ELEVATION: ...
 Depth(s) Groundwater Encountered 1. 20' ft. 2. ... ft. 3. ... ft.
 WELL'S STATIC WATER LEVEL ... 11' ft. below land surface measured on mo/day/yr 4-09-90
 Pump test data: Well water was ... ft. after ... hours pumping ... gpm
 Est. Yield ... 7 ... gpm: Well water was ... ft. after ... hours pumping ... gpm
 Bore Hole Diameter ... 12" in. to ... ft., and ... in. to ... ft.
 WELL WATER TO BE USED AS: 5 Public water supply 8 Air conditioning 11 Injection well
 1 Domestic 3 Feedlot 6 Oil field water supply 9 Dewatering 12 Other (Specify below)
 2 Irrigation 4 Industrial 7 Lawn and garden only 10 Monitoring well
 Was a chemical/bacteriological sample submitted to Department? Yes ... No X ...; If yes, mo/day/yr sample was submitted
 Water Well Disinfected? Yes X No

5 TYPE OF BLANK CASING USED: 5 Wrought iron 8 Concrete tile CASING JOINTS: Glued X Clamped ...
 1 Steel 3 RMP (SR) 6 Asbestos-Cement 9 Other (specify below) Welded ...
 2 PVC 4 ABS 7 Fiberglass Threaded ...
 Blank casing diameter ... 5" in. to ... 0-16 ft., Dia ... 5" in. to ... 26-58 ft., Dia ... in. to ... ft.
 Casing height above land surface ... 24" in., weight ... 2.82 lbs./ft. Wall thickness or gauge No. ... 258
 TYPE OF SCREEN OR PERFORATION MATERIAL: 7 PVC 10 Asbestos-cement
 1 Steel 3 Stainless steel 5 Fiberglass 8 RMP (SR) 11 Other (specify) ...
 2 Brass 4 Galvanized steel 6 Concrete tile 9 ABS 12 None used (open hole)
 SCREEN OR PERFORATION OPENINGS ARE: 5 Gauzed wrapped 8 Saw cut 11 None (open hole)
 1 Continuous slot 3 Mill slot 6 Wire wrapped 9 Drilled holes
 2 Louvered shutter 4 Key punched 7 Torch cut 10 Other (specify) ...
 SCREEN-PERFORATED INTERVALS: From ... 16 ... ft. to ... 26 ... ft., From ... ft. to ... ft.
 GRAVEL PACK INTERVALS: From ... 14 ... ft. to ... 58 ... ft., From ... ft. to ... ft.

6 GROUT MATERIAL: 1 Neat cement 2 Cement grout 3 Bentonite 4 Other hole plug
 Grout Intervals: From ... 0 ... ft. to ... 14 ... ft., From ... ft. to ... ft., From ... ft. to ... ft.
 What is the nearest source of possible contamination: 10 Livestock pens 14 Abandoned water well
 1 Septic tank 4 Lateral lines 7 Pit privy 11 Fuel storage 15 Oil well/Gas well
 2 Sewer lines 5 Cess pool 8 Sewage lagoon 12 Fertilizer storage 16 Other (specify below)
 3 Watertight sewer lines 6 Seepage pit 9 Feedyard 13 Insecticide storage

Direction from well? How many feet?

FROM	TO	LITHOLOGIC LOG	FROM	TO	PLUGGING INTERVALS
0	2	Top Soil			
2	15	Clay-Brown			
15	20	Fine Sand-Coarse Sand-Med-Pea Gravel-Brown			
20	45	Shale-Grey			
45	58	Limestone-Grey			

7 CONTRACTOR'S OR LANDOWNER'S CERTIFICATION: This water well was (1) constructed, (2) reconstructed, or (3) plugged under my jurisdiction and was completed on (mo/day/year) ... 4-09-90 ... and this record is true to the best of my knowledge and belief. Kansas Water Well Contractor's License No. ... 182 ... This Water Well Record was completed on (mo/day/yr) 5-19-90 ... under the business name of STRADER DRILLING CO., INC. by (signature) Jim Baker