

CORRECTION(S) TO WATER WELL RECORD (WWC-5)

(to rectify lacking or incorrect information)

County: Jefferson

Location listed as:

Section-Township-Range: 7-8-20

Fraction (1/4 1/4 1/4): None Given

Location changed to:

7-85-20E

NW NE NW

Other changes: Initial statements: _____

Changed to: _____

Comments: _____


verification method: Legal description, well owner's address, area map on internet, position on plat map, and Easton SW & Potter 1:24,000 topo. maps initials: DRK date: 4/4/2005

submitted by: Kansas Geological Survey, Data Resources Library, 1930 Constant Ave., Lawrence, KS 66047-3726
to: Kansas Dept of Health & Environment, Bureau of Water, 1000 SW Jackson, Suite 420, Topeka, KS 66612-1367.

1 LOCATION OF WATER WELL: Fraction 1/4 1/4 1/4 Section Number 7 Township Number 8 Range Number 20
 County: Jefferson

Distance and direction from nearest town or city street address of well if located within city?

2 WATER WELL OWNER: Margaret A. Domann
 RR #, St. Address, Box #: 18303 182nd St. Board of Agriculture, Division of Water Resources
 City, State, ZIP Code: Winchester, KS 66097 Application Number:

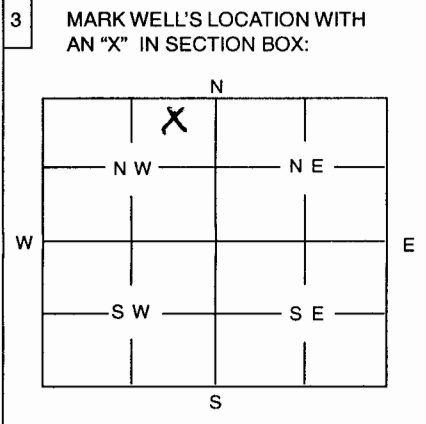

4 DEPTH OF WELL 38 ft
 WELL'S STATIC WATER LEVEL 2 ft.
 WELL WAS USED AS:
 Domestic 5 Public Water Supply 9 Dewatering
 2 Irrigation 6 Oil Field Water Supply 10 Monitoring Well
 3 Feedlot 7 Domestic (Lawn & Garden) 11 Injection Well
 4 Industrial 8 Air Conditioning 12 Other

Was a chemical / bacteriological sample submitted to Department? Yes No
 If yes, mo/day/yr sample was submitted

Water Well Disinfected: Yes No

5 TYPE OF BLANK CASING USED:
 1 Steel 3 RMP (SR) 5 Wrought 7 Fiberglass 9 Other (Specify below) rock
 2 PVC 4 ABS 6 Asbestos-Cement 8 Concrete Tile

Blank casing diameter in. Was casing pulled? Yes No If yes, how much

Casing height above or below land surface in.

6 GROUT PLUG MATERIAL: 1 Neat cement 2 Cement grout 3 Bentonite 4 Other

Grout Plug Intervals: From ft. to ft., From ft. to ft., From to ft.

What is the nearest source of possible contamination:
 1 Septic tank 6 Seepage pit 11 Fuel storage 16 Other (specify below)
 2 Sewer lines 7 Pit privy 12 Fertilizer storage
 3 Watertight sewer lines 8 Sewage lagoon 13 Insecticide storage
 4 Lateral lines 9 Feedyard 14 Abandoned water well
 5 Cess Pool 10 Livestock pens 15 Oil well/Gas well

Direction from well? How many feet? none

FROM	TO	PLUGGING MATERIALS
<u>1.5 gal.</u>		<u>Chlorine</u>
<u>11.55 tons</u>		<u>Scened</u>
<u>13 bags</u>		<u>Bentonite</u>
		<u>Sand & dirt fill</u>

7 CONTRACTOR'S OR LANDOWNER'S CERTIFICATION: This water well was plugged under my jurisdiction and was completed on (mo/day/year) March 13-05 and this record is true to the best of my knowledge and belief. Kansas Water Well Contractor's License No. 3-13-05 This Water Well Record was completed on (mo/day/year) under the business name of R. Dean Domann by (signature) R. Dean Domann

INSTRUCTIONS: Use typewriter or ball point pen. Please press firmly and print clearly. Please fill in blanks, underline or circle the correct answers. Send top three copies to Kansas Department of Health and Environment, Bureau of Water, Topeka, Kansas 66620-0001. Telephone: 785/296-3565. Send one to Water Well Owner and retain one for your records.