

CORRECTION(S) TO WATER WELL RECORD (WWC-5)

(to rectify lacking or incorrect information)

County: Jefferson

Location listed as:

Section-Township-Range: 7-8S-20E

Fraction ($\frac{1}{4}$ $\frac{1}{4}$ $\frac{1}{4}$): None Given

Location changed to:

7-8S-20E

SE NE NE

Other changes: Initial statements: _____

Changed to: _____

Comments: _____


verification method: Written & legal descriptions, well owner's address,
area road map on internet, position on plat map, and
Easton SW 1:24,000 topo. map. initials: DRJ date: 9/22/2005

submitted by: Kansas Geological Survey, Data Resources Library, 1930 Constant Ave., Lawrence, KS 66047-3726
to: Kansas Dept of Health & Environment, Bureau of Water, 1000 SW Jackson, Suite 420, Topeka, KS 66612-1367.

1 LOCATION OF WATER WELL: Fraction $\frac{1}{4}$ $\frac{1}{4}$ $\frac{1}{4}$ Section Number 7 Township Number 85 Range Number 20E
 County: Jefferson

Distance and direction from nearest town or city street address of well if located within city?
3/4 m No. 175th + Stitz Rd

2 WATER WELL OWNER: DENNIS B. SCHRIK
 RR #, St. Address, Box #: 17871 STITZ RD Board of Agriculture, Division of Water Resources
 City, State, ZIP Code: WINCHESTER KS 66097 Application Number:

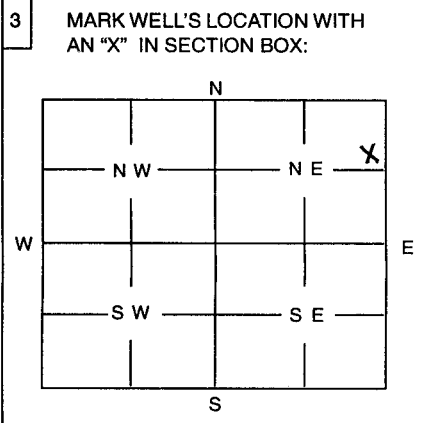

4 DEPTH OF WELL 30' ft
 WELL'S STATIC WATER LEVEL 10' ft
 WELL WAS USED AS:
 1 Domestic 5 Public Water Supply 9 Dewatering
 2 Irrigation 6 Oil Field Water Supply 10 Monitoring Well
 3 Feedlot 7 Domestic (Lawn & Garden) 11 Injection Well
 4 Industrial 8 Air Conditioning 12 Other
 Was a chemical / bacteriological sample submitted to Department? Yes No
 If yes, mo/day/yr sample was submitted
 Water Well Disinfected: Yes No

5 TYPE OF BLANK CASING USED:
 1 Steel 3 RMP (SR) 5 Wrought 7 Fiberglass 9 Other (Specify below)
 2 PVC 4 ABS 6 Asbestos-Cement 8 Concrete Tile
 Blank casing diameter 2" in. Was casing pulled? Yes No If yes, how much
 Casing height above or below land surface 5 FT in.

6 GROUT PLUG MATERIAL: 1 Neat cement 2 Cement grout 3 Bentonite 4 Other
 Grout Plug Intervals: From 14 ft. to 15 ft., From ft. to ft., From to ft.
 What is the nearest source of possible contamination:
 1 Septic tank 6 Seepage pit 11 Fuel storage 16 Other (specify below)
 2 Sewer lines 7 Pit privy 12 Fertilizer storage
 3 Watertight sewer lines 8 Sewage lagoon 13 Insecticide storage
 4 Lateral lines 9 Feedyard 14 Abandoned water well
 5 Cess Pool 10 Livestock pens 15 Oil well/Gas well
 Direction from well? NW How many feet? 50'

FROM	TO	PLUGGING MATERIALS
0'	10'	ROCK - SAND
10'	14'	LIME - SAND
14'	15'	BENTONITE
15'	30'	CLAY - TOPSOIL

7 CONTRACTOR'S OR LANDOWNER'S CERTIFICATION: This water well was plugged under my jurisdiction and was completed on (mo/day/year) 9-3-05 and this record is true to the best of my knowledge and belief. Kansas Water Well Contractor's License No. This Water Well Record was completed on (mo/day/year)
 by (signature) Dennis B. Schrik under the business name of

INSTRUCTIONS: Use typewriter or ball point pen. Please press firmly and print clearly. Please fill in blanks, underline or circle the correct answers. Send top three copies to Kansas Department of Health and Environment, Bureau of Water, Topeka, Kansas 66620-0001. Telephone: 785/296-3565. Send one to Water Well Owner and retain one for your records.