

**WATER WELL PLUGGING RECORD Form WWC-5P**

KSA 82a-1212

ID NO.

OB-2-15


<b>1 LOCATION OF WATER WELL:</b> County: <b>Leavenworth</b>	Fraction <b>SE ¼ SE ¼ SE ¼ SW ¼</b>	Section Number <b>18</b>	Township Number <b>T 8 S</b>	Range Number <b>21</b> <input checked="" type="checkbox"/> E <input type="checkbox"/> W
--	--	-----------------------------	---------------------------------	--

Street/Rural Address of Well Location; if unknown, distance & direction from nearest town or intersection: If at owner's address, check here  Approximately 0.5 miles northwest of the intersection of Dawson St. and 231st St. in Easton.

**Global Positioning Systems (GPS) information:**  
 Latitude: **39.346729** (in decimal degrees)  
 Longitude: **-95.115103** (in decimal degrees)  
 Elevation: **Unknown**  
 Horizontal Datum:  WGS84,  NAD83,  NAD27  
 Collection Method:

**2 WATER WELL OWNER:** City of Easton  
 RR#, St. Address, Box #: **300 W. Riley St.**  
 City, State ZIP Code: **Easton, KS 66020**

GPS unit (Make/Model: **WAAS**)  
 Digital Map/Photo,  Topographic Map,  Land Survey  
 Est. Accuracy:  < 3 m,  3-5 m,  5-15 m,  > 15 m

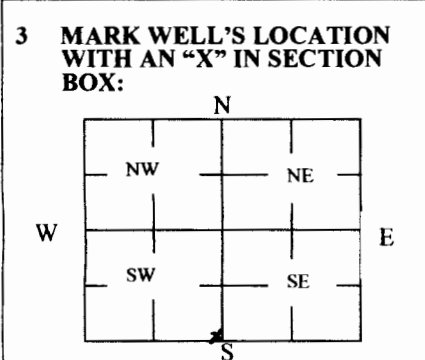

**4 DEPTH OF WELL** 60 ft.  
 WELL'S STATIC WATER LEVEL 4 ft  
 WELL WAS USED AS:  
 Domestic     Public Water Supply     Dewatering  
 Irrigation     Oil Field Water Supply     Monitoring  
 Feedlot     Domestic (Lawn & Garden)     Injection Well  
 Industrial     Air Conditioning     Other Observation  
 Was a chemical/bacteriological sample submitted to Department? Yes  No

**5 TYPE OF BLANK CASING USED:**

Steel     RMP (SR)     Wrought     Fiberglass     Other (Specify below)  
 PVC     ABS     Asbestos-Cement     Concrete Tile

Blank casing diameter 2 in. Was casing pulled? Yes  No  If yes, how much \_\_\_\_\_  
 Casing height above or below land surface 36 in.

**6 GROUT PLUG MATERIAL:**  Neat cement     Cement grout     Bentonite     Other \_\_\_\_\_

Grout Plug Intervals: From 3 ft. to 60 ft., From \_\_\_\_\_ ft. to \_\_\_\_\_ ft., From \_\_\_\_\_ ft. to \_\_\_\_\_ ft.

What is the nearest source of possible contamination:  
 Septic tank     Seepage pit     Fuel storage     Other (specify below)  
 Sewer lines     Pit privy     Fertilizer storage    None Known  
 Watertight sewer lines     Sewage lagoon     Insecticide storage  
 Lateral lines     Feedyard     Abandoned water well    Direction from well? \_\_\_\_\_  
 Cess pool     Livestock pens     Oil well/Gas well    How many feet? \_\_\_\_\_

FROM	TO	PLUGGING MATERIALS	FROM	TO	PLUGGING MATERIALS
3	60	Bentonite chips			

**7 CONTRACTOR'S OR LANDOWNER'S CERTIFICATION:** This water well was plugged under my jurisdiction and was completed on (mo/day/year) 1/17/2017 and this record is true to the best of my knowledge and belief. Kansas Water Well Contractor's License No. 909. This Water Well Record was completed on (mo/day/year) 1/17/2017 under the business name of Brotcke Well & Pump, Inc. by (signature) [Signature]

Send one white copy to Kansas Department of Health & Environment, Geology Section, 1000 SW Jackson Street, Ste. 420, Topeka, KS 66612-1367. Send one copy to WATER WELL OWNER and retain one for your records.  
 Visit us at <http://www.kdheks.gov/waterwell/index.html> Telephone 785-296-5524.