

1 LOCATION OF WATER WELL:	Fraction	Section Number	Township Number	Range Number
County: LEAVENWORTH	SE ¼ NW ¼ SW ¼	28	T 8 S	R 22 E/W


Distance and direction from nearest town or city street address of well if located within city?

1 west of Leavenworth

2	WATER WELL OWNER:	Jim McKinney	
	RR#, St. Address, Box # :	16937 Dakota	Board of Agriculture, Division of Water Resources
	City, State, ZIP Code :	Leavenworth, KS 66048	Application Number:

3 LOCATE WELL'S LOCATION WITH AN "X" IN SECTION BOX: 4 DEPTH OF COMPLETED WELL: 200' ft. ELEVATION: \_\_\_\_\_

Depth(s) Groundwater Encountered	1	103-132	ft	2	ft	3	ft

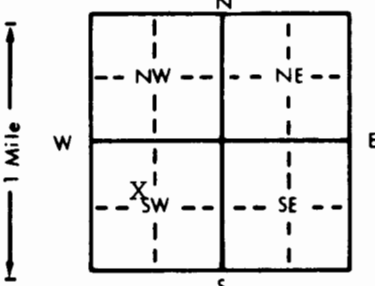

4) DEPTH OF COMPLETED WELL: 200' ft. ELEVATION: \_\_\_\_\_

Depth(s) Groundwater Encountered 1. 103-132 ft. 2. \_\_\_\_\_ ft. 3. \_\_\_\_\_ ft.

WELL'S STATIC WATER LEVEL 90' ft. below land surface measured on mo/day/yr 4-02-96

Pump test data: Well water was \_\_\_\_\_ ft. after \_\_\_\_\_ hours pumping \_\_\_\_\_ gpm

Est. Yield 2 gpm: Well water was \_\_\_\_\_ ft. after \_\_\_\_\_ hours pumping \_\_\_\_\_ gpm

Bore Hole Diameter 8 3/4 in. to \_\_\_\_\_ ft., and \_\_\_\_\_ in. to \_\_\_\_\_ ft.

WELL WATER TO BE USED AS:

1 Domestic	3 Feedlot	6 Oil field water supply	9 Dewatering	12 Other (Specify below)
2 Irrigation	4 Industrial	7 Lawn and garden only	10 Monitoring well	

Was a chemical/bacteriological sample submitted to Department? Yes \_\_\_\_\_ No X \_\_\_\_\_; If yes, mo/day/yr sample was submitted \_\_\_\_\_

Water Well Disinfected? Yes X \_\_\_\_\_ No \_\_\_\_\_

5 TYPE OF BLANK CASING USED:		5 Wrought iron	8 Concrete tile	CASING JOINTS: Glued <input checked="" type="checkbox"/> Clamped <input type="checkbox"/>
1 Steel	3 RMP (SR)	6 Asbestos-Cement	9 Other (specify below)	Welded <input type="checkbox"/>
2 PVC	4 ABS	7 Fiberglass		Threaded <input type="checkbox"/>

Blank casing diameter . . . . . 5" . . . in. to . . . 0-100 . . . ft., Dia . . . 5" . . . in. to . . . 140-196 ft., Dia . . . in. to . . . ft.  
Casing height above land surface . . . . . 24" . . . in., weight . . . 2.82 . . . lbs./ft. Wall thickness or gauge No. . . . . .258

TYPE OF SCREEN OR PERFORATION MATERIAL:			<u>7 PVC</u>	10 Asbestos-cement
1 Steel	3 Stainless steel	5 Fiberglass	8 RMP (SR)	11 Other (specify) . . . . .
2 Brass	4 Galvanized steel	6 Concrete tile	9 ABS	12 None used (open hole)

SCREEN OR PERFORATION OPENINGS ARE:		5 Gauzed wrapped	<u>8 Saw cut</u>	11 None (open hole)
1 Continuous slot	3 Mill slot	6 Wire wrapped	9 Drilled holes	
2 Louvered shutter	4 Key punched	7 Torch cut	10 Other (specify) .....	

SCREEN-PERFORATED INTERVALS:	From . . . 100 . . . . .	ft. to . . . 140 . . . . .	ft., From . . . . .	ft. to . . . . .	ft.
	From . . . 196 . . . . .	ft. to . . . 200 . . . . .	ft., From . . . . .	ft. to . . . . .	ft.
GRAVEL PACK INTERVALS:	From . . . 24 . . . . .	ft. to . . . 200 . . . . .	ft., From . . . . .	ft. to . . . . .	ft.
	From . . . . .	ft. to . . . . .	ft., From . . . . .	ft. to . . . . .	ft.

6. GROUT MATERIAL: 1 Neat cement 2 Cement grout 3 Bentonite 4 Other \_\_\_\_\_  
Grout Intervals: From 4 ft. to 24 ft. From \_\_\_\_\_ ft. to \_\_\_\_\_ ft. From \_\_\_\_\_ ft. to \_\_\_\_\_ ft.

What is the nearest source of possible contamination:

1 Septic tank	4 Lateral lines	7 Pit privy	10 Livestock pens	14 Abandoned water well
2 Sewer lines	5 Cess pool	8 Sewage lagoon	11 Fuel storage	15 Oil well/Gas well
3 Watertight sewer lines	6 Seepage pit	9 Feedyard	12 Fertilizer storage	16 Other (specify below)
			13 Insecticide storage	pond

Direction from well? \_\_\_\_\_

How many feet? \_\_\_\_\_

Direction from well?		east		How many feet?		400	
FROM	TO	LITHOLOGIC LOG		FROM	TO	PLUGGING INTERVALS	

0	18	Clay-Brown			
18	20	Shale-Yellow			
20	22	Sandstone-Brown			
22	94	Shale-Grey			
94	98	Limestone-Grey			
98	103	Shaley LS-Grey			
103	132	Sandstone-Grey			
132	149	Shale-Grey			
149	150	Sandstone-Grey			
150	153	Limestone-Grey			
153	170	Sandy Shale-Grey			
170	186	Shale-Grey			
186	187	Limestone-Grey			
187	200	Shale-Grey			

7. CONTRACTOR'S OR LANDOWNER'S CERTIFICATION: This water well was (1) constructed, (2) reconstructed, or (3) plugged under my jurisdiction and was completed on (mo/day/year) 4-02-96 and this record is true to the best of my knowledge and belief. Kansas Water Well Contractor's License No. 182 This Water Well Record was completed on (mo/day/yr) 4-12-96 under the business name of STRADER DRILLING CO., INC. by (signature) Dale Ashren