


1 LOCATION OF WATER WELL: Fraction  $\frac{1}{4}$  NW  $\frac{1}{4}$  NW  $\frac{1}{4}$  Section Number 13 Township Number T 8 S Range Number R 22 EX  
 County: LEAVENWORTH

Distance and direction from nearest town or city street address of well if located within city?  
 MW-5 @ Stoddard site in Leavenworth Disciplinary Barracks

2 WATER WELL OWNER: USACE % Burns & McDonnell (Bill Craig)  
 RR#, St. Address, Box #: 10881 Lowell Board of Agriculture, Division of Water Resources  
 City, State, ZIP Code: Overland Park KS 66210 Application Number:

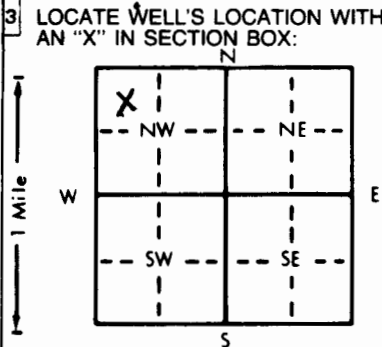

4 DEPTH OF COMPLETED WELL: 51.5 ft. ELEVATION:  
 Depth(s) Groundwater Encountered 1. . . . . ft. 2. . . . . ft. 3. . . . . ft.  
 WELL'S STATIC WATER LEVEL . . . . . ft. below land surface measured on mo/day/yr  
 Pump test data: Well water was . . . . . ft. after . . . . . hours pumping . . . . . gpm  
 Est. Yield . . . . . gpm: Well water was . . . . . ft. after . . . . . hours pumping . . . . . gpm  
 Bore Hole Diameter: 8 in. to 51.5 ft., and . . . . . in. to . . . . . ft.  
 WELL WATER TO BE USED AS: 5 Public water supply 8 Air conditioning 11 Injection well  
 1 Domestic 3 Feedlot 6 Oil field water supply 9 Dewatering 12 Other (Specify below)  
 2 Irrigation 4 Industrial 7 Lawn and garden only 10 Monitoring well  
 Was a chemical/bacteriological sample submitted to Department? Yes. . . . . No. X . . . . .; If yes, mo/day/yr sample was submitted  
 Water Well Disinfected? Yes No

5 TYPE OF BLANK CASING USED: 5 Wrought iron 8 Concrete tile CASING JOINTS: Glued . . . . . Clamped  
 1 Steel 3 RMP (SR) 6 Asbestos-Cement 9 Other (specify below) Welded . . . . .  
 2 PVC 4 ABS 7 Fiberglass . . . . . Threaded. Yes  
 Blank casing diameter 2 in. to 31 ft., Dia . . . . . in. to . . . . . ft., Dia . . . . . in. to . . . . . ft.  
 Casing height above land surface 0 in., weight 2ch 40 lbs./ft. Wall thickness or gauge No. . . . .  
 TYPE OF SCREEN OR PERFORATION MATERIAL: 7 PVC 10 Asbestos-cement  
 1 Steel 3 Stainless steel 5 Fiberglass 8 RMP (SR) 11 Other (specify) . . . . .  
 2 Brass 4 Galvanized steel 6 Concrete tile 9 ABS 12 None used (open hole)  
 SCREEN OR PERFORATION OPENINGS ARE: 5 Gauzed wrapped 8 Saw cut 11 None (open hole)  
 1 Continuous slot 3 Mill slot 6 Wire wrapped 9 Drilled holes  
 2 Louvered shutter 4 Key punched 7 Torch cut 10 Other (specify) . . . . .  
 SCREEN-PERFORATED INTERVALS: From 31 ft. to 51 ft., From . . . . . ft. to . . . . . ft.  
 From . . . . . ft. to . . . . . ft., From . . . . . ft. to . . . . . ft.  
 GRAVEL PACK INTERVALS: From 25.5 ft. to 51.5 ft., From . . . . . ft. to . . . . . ft.  
 From . . . . . ft. to . . . . . ft., From . . . . . ft. to . . . . . ft.

6 GROUT MATERIAL: 1 Neat cement 2 Cement grout 3 Bentonite 4 Other . . . . .  
 Grout Intervals: From 25.5 ft. to 22.5 ft., From 22.5 ft. to 0 ft., From . . . . . ft. to . . . . . ft.  
 What is the nearest source of possible contamination:  
 1 Septic tank 4 Lateral lines 7 Pit privy 10 Livestock pens 14 Abandoned water well  
 2 Sewer lines 5 Cess pool 8 Sewage lagoon 11 Fuel storage 15 Oil well/Gas well  
 3 Watertight sewer lines 6 Seepage pit 9 Feedyard 12 Fertilizer storage 16 Other (specify below)  
 Standard solvent tank  
 Direction from well? How many feet?

FROM	TO	LITHOLOGIC LOG	FROM	TO	PLUGGING INTERVALS
0	2	Brown silty clay (fill)			
2	9.5	Rubble fill			
9.5	32.9	Lt. brown silty clay			
32.9	47.8	Gray green silty clay			
47.8	51.5	Yellow brown silty clay			

7 CONTRACTOR'S OR LANDOWNER'S CERTIFICATION: This water well was (1) constructed, (2) reconstructed, or (3) plugged under my jurisdiction and was completed on (mo/day/year) 4/18/96 and this record is true to the best of my knowledge and belief. Kansas Water Well Contractor's License No. 570 This Water Well Record was completed on (mo/day/year) 4/25/96 under the business name of AQUADRILL, INC. by (signature) Jeffrey L. Jahn