


LEAVENWORTH

02968014

1 LOCATION OF WATER WELL:	Fraction	Section Number	Township Number	Range Number
County: DELAWARE	SE 1/4 NW 1/4 NE 1/4	35	T 8 S	R 22 EW

Distance and direction from nearest town or city street address of well if located within city?
745 N. DELAWARE, LEAVENWORTH, KS

2 WATER WELL OWNER: GENUINE PARTS CO	MW-1
RR#, St. Address, Box #: 4100 PERIMETER PARK SOUTH	Board of Agriculture, Division of Water Resources
City, State, ZIP Code: ATLANTA GA 30341	Application Number:

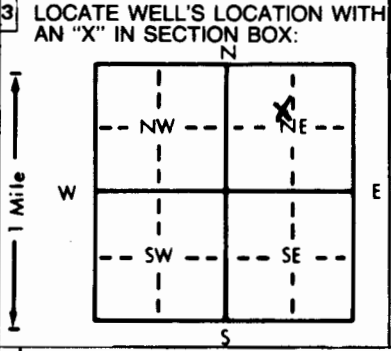

4 DEPTH OF COMPLETED WELL: 30.5 ft.	ELEVATION:
Depth(s) Groundwater Encountered 1. 20.0 ft. 2. . ft. 3. . ft.	
WELL'S STATIC WATER LEVEL ft. below land surface measured on mo/day/yr	
Pump test data: Well water was ft. after hours pumping gpm	
Est. Yield gpm: Well water was ft. after hours pumping gpm	
Bore Hole Diameter: 8.25 in. to 31.0 ft., and in. to ft.	
WELL WATER TO BE USED AS:	
5 Public water supply 8 Air conditioning 11 Injection well	
1 Domestic 3 Feedlot 6 Oil field water supply 9 Dewatering 12 Other (Specify below)	
2 Irrigation 4 Industrial 7 Lawn and garden only 10 Monitoring well	
Was a chemical/bacteriological sample submitted to Department? Yes No <input checked="" type="checkbox"/> ; If yes, mo/day/yr sample was submitted	
Water Well Disinfected? Yes No <input checked="" type="checkbox"/>	

5 TYPE OF BLANK CASING USED:	5 Wrought iron	8 Concrete tile	CASING JOINTS: Glued Clamped
1 Steel	3 RMP (SR)	6 Asbestos-Cement	9 Other (specify below)
2 PVC	4 ABS	7 Fiberglass	Welded
Blank casing diameter 2 in. to 18.0 ft., Dia in. to ft., Dia in. to ft.			Threaded <input checked="" type="checkbox"/>
Casing height above land surface 0 in., weight lbs./ft. Wall thickness or gauge No. SCHED 40			
TYPE OF SCREEN OR PERFORATION MATERIAL:	1 Steel	3 Stainless steel	5 Fiberglass
2 Brass	4 Galvanized steel	6 Concrete tile	9 ABS
SCREEN OR PERFORATION OPENINGS ARE:	1 Continuous slot	2 Mill slot 0.010	3 Gauzed wrapped
2 Louvered shutter	4 Key punched	5 Wire wrapped	6 Saw cut
SCREEN-PERFORATED INTERVALS: From 18.0 ft. to 30.5 ft., From ft. to ft.			7 Torch cut
GRAVEL PACK INTERVALS: From 16.0 ft. to 31.0 ft., From ft. to ft.			8 RMP (SR)
			9 Other (specify)
			10 Asbestos-cement
			11 None used (open hole)
			12 None used (open hole)

6 GROUT MATERIAL:	1 Neat cement	2 Cement grout	3 Bentonite	4 Other
Grout Intervals: 2 From 0.0 ft. to 5.0 ft., 3 From 5.0 ft. to 16.0 ft., From ft. to ft.				
What is the nearest source of possible contamination:	1 Septic tank	4 Lateral lines	7 Pit privy	10 Livestock pens
2 Sewer lines	5 Cess pool	8 Sewage lagoon	11 Fuel storage	14 Abandoned water well
3 Watertight sewer lines	6 Seepage pit	9 Feedyard	12 Fertilizer storage	15 Oil well/Gas well
			13 Insecticide storage	Other (specify below) WASTE OIL
Direction from well?			How many feet?	

FROM	TO	LITHOLOGIC LOG	FROM	TO	PLUGGING INTERVALS
0.0	0.5	ASPHALT			
0.5	5.0	FILL (BRICK, CINDERS)			
5.0	7.0	SILTY CLAY BLACK			
7.0	11.0	CLAY BLACK			
11.0	16.0	CLAY GREENISH GRAY			
16.0	31.0	CLAY BROWN - GRAY			

7 CONTRACTOR'S OR LANDOWNER'S CERTIFICATION: This water well was 1 constructed, (2) reconstructed, or (3) plugged under my jurisdiction and was completed on (mo/day/year) 6-18-96 and this record is true to the best of my knowledge and belief. Kansas Water Well Contractor's License No. 416 This Water Well Record was completed on (mo/day/yr) 9-18-96 under the business name of TERRACON CONSULTANTS INC by (signature) Clay P. Aly
--