


1 LOCATION OF WATER WELL: County Leavenworth Fraction SE 1/4 SW 1/4 NE 1/4 Section Number 35 Township Number T 8 S Range Number R 22 EW

Distance and direction from nearest town or city street address of well if located within city?  
788 Spruce, Leavenworth, Ks.

2 WATER WELL OWNER: Wood's Mini Mart  
 RR#, St. Address, Box #: 788 Spruce P.O. Box 67 Board of Agriculture, Division of Water Resources  
 City, State, ZIP Code: Leavenworth, Ks. 66048 Application Number:

3 LOCATE WELL'S LOCATION WITH AN "X" IN SECTION BOX:

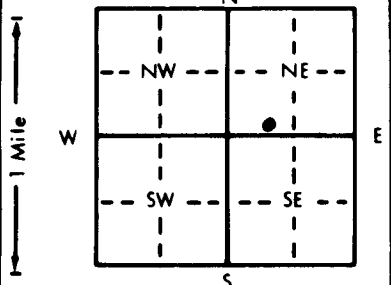

4 DEPTH OF COMPLETED WELL: 15' ft. ELEVATION:

Depth(s) Groundwater Encountered 1.9' ft. 2. .... ft. 3. .... ft.  
 WELL'S STATIC WATER LEVEL 4.57 ft. below land surface measured on mo/day/yr  
 Pump test data: Well water was ..... ft. after ..... hours pumping ..... gpm  
 Est. Yield ..... gpm: Well water was ..... ft. after ..... hours pumping ..... gpm  
 Bore Hole Diameter 8 1/2" in. to 15' ft., and ..... in. to ..... ft.  
 WELL WATER TO BE USED AS:  
 1 Domestic 3 Feedlot 6 Oil field water supply 9 Dewatering 12 Other (Specify below)  
 2 Irrigation 4 Industrial 7 Lawn and garden only 10 Monitoring well  
 Was a chemical/bacteriological sample submitted to Department? Yes ..... No X .....; If yes, mo/day/yr sample was submitted  
 Water Well Disinfected? Yes ..... No 10 .....

5 TYPE OF BLANK CASING USED:

1 Steel 3 RMP (SR) 5 Wrought iron 8 Concrete tile CASING JOINTS: Glued ..... Clamped .....  
2 PVC 4 ABS 7 Fiberglass ..... Welded .....  
 Blank casing diameter 2.375 in. to 5' ft., Dia ..... in. to ..... ft., Dia ..... in. to SDR 13 ft.  
 Casing height above land surface Flush Mount in., weight ..... lbs./ft. Wall thickness or gauge No. SCH. 40

TYPE OF SCREEN OR PERFORATION MATERIAL:  
 1 Steel 3 Stainless steel 5 Fiberglass 7 PVC 10 Asbestos-cement  
 2 Brass 4 Galvanized steel 6 Concrete tile 8 RMP (SR) 11 Other (specify) .....  
 9 ABS 12 None used (open hole)

SCREEN OR PERFORATION OPENINGS ARE:  
 1 Continuous slot 3 Mill slot 5 Gauzed wrapped 8 Saw cut 11 None (open hole)  
 2 Louvered shutter 4 Key punched 6 Wire wrapped 9 Drilled holes  
 7 Torch cut 10 Other (specify) .....

SCREEN-PERFORATED INTERVALS: From 15' ft. to 5' ft., From ..... ft. to ..... ft.  
 From ..... ft. to ..... ft., From ..... ft. to ..... ft.  
 GRAVEL PACK INTERVALS: From 15' ft. to 4' ft., From ..... ft. to ..... ft.  
 From ..... ft. to ..... ft., From ..... ft. to ..... ft.

6 GROUT MATERIAL: 1 Neat cement 2 Cement grout 3 Bentonite 4 Other .....  
 Grout Intervals: From 4' ft. to 3' ft., From 3' ft. to 0' ft., From ..... ft. to ..... ft.

What is the nearest source of possible contamination:  
 1 Septic tank 4 Lateral lines 7 Pit privy 10 Livestock pens 14 Abandoned water well  
 2 Sewer lines 5 Cess pool 8 Sewage lagoon 11 Fuel storage 15 Oil well/Gas well  
 3 Watertight sewer lines 6 Seepage pit 9 Feedyard 12 Fertilizer storage 16 Other (specify below)  
 13 Insecticide storage  
 Direction from well? East How many feet? 85'

FROM	TO	LITHOLOGIC LOG	FROM	TO	PLUGGING INTERVALS
0	.25	Broken asphalt, gravel.			
.25	6	Dk brn clay w/ gray clay mottling, moist-dry, firm, no odor.			
6	9	Med brn silty clay w/ oxide staining & dk gray clay stringers, moist, no odor, firm.			
9	15	Lt brn silty clay, moist to wet at 9', no odor, soft.			
					<i>FM. OK'd by Don Taylor</i>

7 CONTRACTOR'S OR LANDOWNER'S CERTIFICATION: This water well was (1) constructed, (2) reconstructed, or (3) plugged under my jurisdiction and was completed on (mo/day/year) 8-29-96 and this record is true to the best of my knowledge and belief. Kansas Water Well Contractor's License No. 539 This Water Well Record was completed on (mo/day/yr) 9-6-96 under the business name of JB Environmental Drilling by (signature) James Bieber