


WATER WELL RECORD Form WWC-5 KSA 82a-1212

1 LOCATION OF WATER WELL: County: Leavenworth Fraction NW 1/4 NE 1/4 NE 1/4 Section Number 35 Township Number T 8 S Range Number R 22 EW

Distance and direction from nearest town or city street address of well if located within city? 210 S. Broadway, Leavenworth, Kansas

2 WATER WELL OWNER: Thomas Oil Company RR#, St. Address, Box #: 1313 Vilas Board of Agriculture, Division of Water Resources City, State, ZIP Code: Leavenworth, Kansas 66048 Application Number:

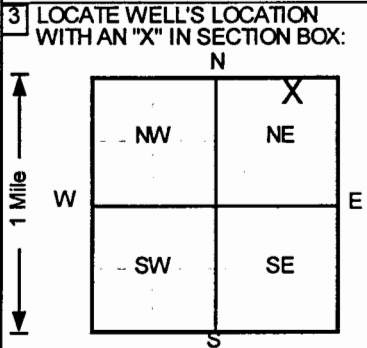

3 LOCATE WELL'S LOCATION WITH AN "X" IN SECTION BOX: 4 DEPTH OF COMPLETED WELL: 15 ft ELEVATION: 783.78 ft. WELL'S STATIC WATER LEVEL: 11.67 ft below land surface measured on 10/24/97. Pump test data: Well water was NA ft after hours pumping gpm. Est. Yield: NA gpm. Bore Hole Diameter: 8 in. to 15 ft. WELL WATER TO BE USED AS: 10 Monitoring well. Was a chemical/bacteriological sample submitted? No. Water Well Disinfected? No.

5 TYPE OF BLANK CASING USED: 2 PVC, 3 RMP (SR), 5 Wrought iron, 8 Concrete tile, CASING JOINTS: Threaded. Blank casing diameter: 2 in. to 5 ft, Dia. Casing height above land surface: -6.12 in., weight: Sch 40, lbs./ft. Wall thickness or gauge No.

TYPE OF SCREEN OR PERFORATION MATERIAL: 7 PVC, 10 Asbestos-cement, 11 Other (specify), 12 None used (open hole).

SCREEN OR PERFORATION OPENINGS ARE: 3 Mill slot, 5 Gauzed wrapped, 8 Saw cut, 11 None (open hole), 6 Wire wrapped, 9 Drilled holes, 10 Other (specify).

SCREEN-PERFORATED INTERVALS: From 5 ft to 15 ft. GRAVEL PACK INTERVALS: From 3 ft to 15 ft.

6 GROUT MATERIAL: 2 Cement grout, 3 Bentonite, 4 Other. Grout Intervals: From 0 ft to 1 ft, From 1 ft to 3 ft. What is the nearest source of possible contamination: 16 Other (specify below) Former UST Basin. Direction from well? South. How many feet? 140.

Table with columns: FROM, TO, LITHOLOGIC LOG, FROM, TO, PLUGGING INTERVALS. Rows: 0-0.5 Gravel, 0.5-10 Clay, Dark Brown, 10-15 Clay, Dark Brown/Gray. Additional info: MW9, Tag # 00192510, Flushmount; Project Name: Thomas Oil Co.; GeoCore # 487, KDHE # U4 052 824.

7 CONTRACTOR'S OR LANDOWNER'S CERTIFICATION: This water well was (1) constructed, (2) reconstructed, or (3) plugged under my jurisdiction and was completed on (mo/day/year) 10/23/97 and this record is true to the best of my knowledge and belief. Kansas Water Well Contractor's License No. 527. This Water Well Record was completed on (mo/day/yr) 11/13/97 under the business name of GeoCore Services, Inc. by (signature) [Signature]