


1 LOCATION OF WATER WELL: County: Leavenworth Fraction: NW 1/4 NE 1/4 SW 1/4 Section Number: 24 Township Number: T 8 S Range Number: R 22 EW

Distance and direction from nearest town or city street address of well if located within city?
In Leavenworth

2 WATER WELL OWNER: Kaez Const.
 RR#, St. Address, Box #: 716 Cherokee
 City, State, ZIP Code: Leavenworth, KS
 Board of Agriculture, Division of Water Resources
 Application Number:

3 LOCATE WELL'S LOCATION WITH AN "X" IN SECTION BOX:

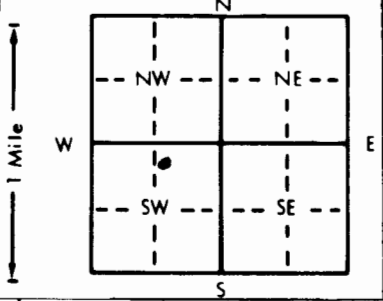

4 DEPTH OF COMPLETED WELL: 20 ft. ELEVATION: _____ ft.
 Depth(s) Groundwater Encountered 1. 13 ft. 2. _____ ft. 3. _____ ft.
 WELL'S STATIC WATER LEVEL: 13.4 ft. below land surface measured on mo/day/yr 3-4-93
 Pump test data: Well water was _____ ft. after _____ hours pumping _____ gpm
 Est. Yield _____ gpm Well water was _____ ft. after _____ hours pumping _____ gpm
 Bore Hole Diameter: 6.5/8 in. to 20ft ft., and _____ in. to _____ ft.
 WELL WATER TO BE USED AS:
 5 Public water supply 8 Air conditioning 11 Injection well
 1 Domestic 3 Feedlot 6 Oil field water supply 9 Dewatering 12 Other (Specify below)
 2 Irrigation 4 Industrial 7 Lawn and garden only 10 Monitoring well
 Was a chemical/bacteriological sample submitted to Department? Yes _____ No X; If yes, mo/day/yr sample was submitted _____
 Water Well Disinfected? Yes _____ No X

5 TYPE OF BLANK CASING USED:
 1 Steel 3 RMP (SR) 5 Wrought iron 8 Concrete tile CASING JOINTS: Glued _____ Clamped _____
2 PVC 4 ABS 6 Asbestos-Cement 9 Other (specify below) Welded _____
 7 Fiberglass Threaded X

Blank casing diameter: 2.42 in. to 10ft ft., Dia _____ in. to _____ ft., Dia _____ in. to _____ ft.
 Casing height above land surface: Flush Mount in., weight _____ lbs./ft. Wall thickness or gauge No. SDR-13
SD 40

TYPE OF SCREEN OR PERFORATION MATERIAL:
 1 Steel 3 Stainless steel 5 Fiberglass 8 RMP (SR) 10 Asbestos-cement 7 PVC SD 40
 2 Brass 4 Galvanized steel 6 Concrete tile 9 ABS 11 Other (specify) _____
 12 None used (open hole)

SCREEN OR PERFORATION OPENINGS ARE:
 1 Continuous slot 3 Mill slot 3 5 Gauzed wrapped 8 Saw cut 11 None (open hole)
 2 Louvered shutter 4 Key punched 6 Wire wrapped 9 Drilled holes
 7 Torch cut 10 Other (specify) _____

SCREEN-PERFORATED INTERVALS: From 20 ft. to 10 ft., From _____ ft. to _____ ft.
 From _____ ft. to _____ ft., From _____ ft. to _____ ft.
 GRAVEL PACK INTERVALS: From 20 ft. to 9 ft., From _____ ft. to _____ ft.
 From _____ ft. to _____ ft., From _____ ft. to _____ ft.

6 GROUT MATERIAL: 1 Neat cement 2 Cement grout 3 Bentonite 4 Other _____
 Grout Intervals: From 9 ft. to 3 ft., From 2 ft. to 0 ft., From _____ ft. to _____ ft.

What is the nearest source of possible contamination:
 1 Septic tank 4 Lateral lines 7 Pit privy 11 Fuel storage 14 Abandoned water well
 2 Sewer lines 5 Cess pool 8 Sewage lagoon 12 Fertilizer storage 15 Oil well/Gas well
 3 Watertight sewer lines 6 Seepage pit 9 Feedyard 13 Insecticide storage 16 Other (specify below) _____

Direction from well? East How many feet? 175ft

FROM	TO	LITHOLOGIC LOG	FROM	TO	PLUGGING INTERVALS
0	1.50	Asphalt w/ ls. gravel base			
1.5	5.0	Brown silty clay			
5.0	10.50	Dk Brown mottled silty clay			
10.50	19.0	Tan-H Brown mottled clay w/ iron oxide staining			
19.0	20.0	Gray weathered shale			

7 CONTRACTOR'S OR LANDOWNER'S CERTIFICATION: This water well was (1) constructed (2) reconstructed, or (3) plugged under my jurisdiction and was completed on (mo/day/year) 3-4-93 and this record is true to the best of my knowledge and belief. Kansas Water Well Contractor's License No. 539 This Water Well Record was completed on (mo/day/yr) 3-9-93 under the business name of J.B. Environmental Drilling by (signature) James Buel

OFFICE USE ONLY
T
R
EW
SEC
1/4
1/4
1/4