


1 LOCATION OF WATER WELL: County: <u>Leavenworth</u>	Fraction <u>NW</u> 1/4 <u>NE</u> 1/4 <u>SW</u> 1/4	Section Number <u>24</u>	Township Number T <u>8</u> S	Range Number R <u>22</u> <u>EW</u>
---	---	-----------------------------	---------------------------------	---------------------------------------

Distance and direction from nearest town or city street address of well if located within city?
In Leavenworth

2 WATER WELL OWNER: Kaaz Const.
 RR#, St. Address, Box #: 716 Cherokee
 City, State, ZIP Code: Leavenworth, Ks.
 Board of Agriculture, Division of Water Resources
 Application Number:

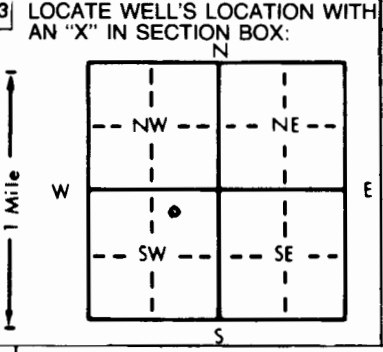

4 DEPTH OF COMPLETED WELL: 15ft. ft. ELEVATION: _____ ft.
 Depth(s) Groundwater Encountered 1. 9 1/2 ft. ft. 2. _____ ft. 3. _____ ft.
 WELL'S STATIC WATER LEVEL 9.4 ft. below land surface measured on mo/day/yr 3-2-93
 Pump test data: Well water was _____ ft. after _____ hours pumping _____ gpm
 Est. Yield _____ gpm: Well water was _____ ft. after _____ hours pumping _____ gpm
 Bore Hole Diameter: 6 5/8 in. to 15ft. ft., and _____ in. to _____ ft.
 WELL WATER TO BE USED AS:
 5 Public water supply 8 Air conditioning 11 Injection well
 1 Domestic 3 Feedlot 6 Oil field water supply 9 Dewatering 12 Other (Specify below)
 2 Irrigation 4 Industrial 7 Lawn and garden only 10 Monitoring well
 Was a chemical/bacteriological sample submitted to Department? Yes _____ No X If yes, mo/day/yr sample was submitted _____
 Water Well Disinfected? Yes _____ No 10

5 TYPE OF BLANK CASING USED:
 1 Steel 3 RMP (SR) 5 Wrought iron 8 Concrete tile CASING JOINTS: Glued _____ Clamped _____
2 PVC 4 ABS 6 Asbestos-Cement 9 Other (specify below) Welded _____
 7 Fiberglass Threaded X
 Blank casing diameter: 2.42 in. to 5ft. ft., Dia _____ in. to _____ ft., Dia _____ in. to _____ ft.
 Casing height above land surface: Flush Mount in., weight _____ lbs./ft. Wall thickness or gauge No. SDR-13
 TYPE OF SCREEN OR PERFORATION MATERIAL:
 1 Steel 3 Stainless steel 5 Fiberglass 8 RMP (SR) 10 Asbestos-cement Sch 40
 2 Brass 4 Galvanized steel 6 Concrete tile 9 ABS 11 Other (specify) _____
 12 None used (open hole)
 SCREEN OR PERFORATION OPENINGS ARE:
 1 Continuous slot 3 Mill slot 5 Gauzed wrapped 8 Saw cut 11 None (open hole)
 2 Louvered shutter 4 Key punched 6 Wire wrapped 9 Drilled holes
 7 Torch cut 10 Other (specify) _____
 SCREEN-PERFORATED INTERVALS: From 15ft. ft. to 5' ft., From _____ ft. to _____ ft.
 From _____ ft. to _____ ft., From _____ ft. to _____ ft.
 GRAVEL PACK INTERVALS: From 15ft. ft. to 4' ft., From _____ ft. to _____ ft.
 From _____ ft. to _____ ft., From _____ ft. to _____ ft.

6 GROUT MATERIAL: 1 Neat cement 2 Cement grout 3 Bentonite 4 Other _____
 Grout Intervals: From 4' ft. to 1 1/2' ft., From 1 1/2' ft. to 0 ft., From _____ ft. to _____ ft.
 What is the nearest source of possible contamination:
 1 Septic tank 4 Lateral lines 7 Pit privy 11 Fuel storage 14 Abandoned water well
 2 Sewer lines 5 Cess pool 8 Sewage lagoon 12 Fertilizer storage 15 Oil well/Gas well
 3 Watertight sewer lines 6 Seepage pit 9 Feedyard 13 Insecticide storage 16 Other (specify below)
 Direction from well? South West How many feet? 40ft

FROM	TO	LITHOLOGIC LOG	FROM	TO	PLUGGING INTERVALS
0	1.50	<u>ls. gravel</u>			
1.50	2.10	<u>dk Brown silty clay</u>			
2.10	6.50	<u>Tan-yellow Brown silty clay w/ iron oxide staining</u>			
6.50	13.50	<u>Green-greenish grey silty sandy clay w/ few fine grained sand lens</u>			
13.50	15.0	<u>Brown-yellow Brown silty sandy clay iron oxide staining, fine grained sand</u>			

7 CONTRACTOR'S OR LANDOWNER'S CERTIFICATION: This water well was (1) constructed (2) reconstructed, or (3) plugged under my jurisdiction and was completed on (mo/day/year) 3-2-93 and this record is true to the best of my knowledge and belief. Kansas Water Well Contractor's License No. 539 This Water Well Record was completed on (mo/day/yr) 3-9-93 under the business name of JB Environmental Drilling by (signature) James Siker

OFFICE USE ONLY
T
R
E/W
SEC.
1/4
1/4
1/4