


1 LOCATION OF WATER WELL: County: Leavenworth Fraction: NW 1/4 NE 1/4 SW 1/4 Section Number: 24 Township Number: T 8 S Range Number: R 22 (EW)

Distance and direction from nearest town or city street address of well if located within city?
In Leavenworth

2 WATER WELL OWNER: Kaaz Construction
 RR#, St. Address, Box #: 716 Cherokee Board of Agriculture, Division of Water Resources
 City, State, ZIP Code: Leavenworth, Ks. Application Number:

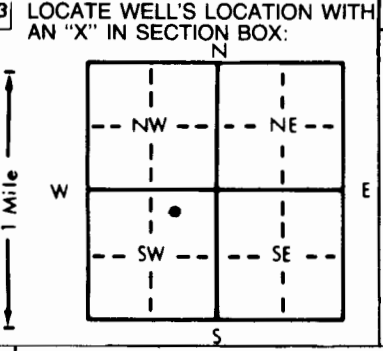

4 DEPTH OF COMPLETED WELL: 15ft. ft. ELEVATION: ft.
 Depth(s) Groundwater Encountered 1. 10ft. ft. 2. ft. 3. ft.
 WELL'S STATIC WATER LEVEL: 10.2 ft. below land surface measured on mo/day/yr 3-2-93
 Pump test data: Well water was ft. after hours pumping gpm
 Est. Yield gpm: Well water was ft. after hours pumping gpm
 Bore Hole Diameter: 6 5/8 in. to 15ft. ft., and in. to ft.
 WELL WATER TO BE USED AS:
 5 Public water supply 8 Air conditioning 11 Injection well
 1 Domestic 3 Feedlot 6 Oil field water supply 9 Dewatering 12 Other (Specify below)
 2 Irrigation 4 Industrial 7 Lawn and garden only 10 Monitoring well
 Was a chemical/bacteriological sample submitted to Department? Yes.....No...X.....; If yes, mo/day/yr sample was submitted
 Water Well Disinfected? Yes (No)

5 TYPE OF BLANK CASING USED:
 1 Steel 3 RMP (SR) 5 Wrought iron 8 Concrete tile CASING JOINTS: Glued Clamped
2 PVC 4 ABS 6 Asbestos-Cement 9 Other (specify below) Welded
 7 Fiberglass Threaded X
 Blank casing diameter 2.40 in. to 5ft. ft., Dia in. to ft., Dia in. to ft.
 Casing height above land surface: Flush Mount in., weight lbs./ft. Wall thickness or gauge No. SDR-13
 TYPE OF SCREEN OR PERFORATION MATERIAL:
 1 Steel 3 Stainless steel 5 Fiberglass 8 RMP (SR) 10 Asbestos-cement Sch 40
 2 Brass 4 Galvanized steel 6 Concrete tile 9 ABS 12 None used (open hole)
 SCREEN OR PERFORATION OPENINGS ARE:
 1 Continuous slot 1 Mill slot 5 Gauzed wrapped 8 Saw cut 11 None (open hole)
 2 Louvered shutter 4 Key punched 6 Wire wrapped 9 Drilled holes
 7 Torch cut 10 Other (specify)
 SCREEN-PERFORATED INTERVALS: From... 15ft. ft. to 5ft. ft., From ft. to ft.
 From ft. to ft., From ft. to ft.
 GRAVEL PACK INTERVALS: From... 15ft. ft. to 4ft. ft., From ft. to ft.
 From ft. to ft., From ft. to ft.

6 GROUT MATERIAL: 1 Neat cement 2 Cement grout 3 Bentonite 4 Other
 Grout Intervals: From... 4ft. ft. to 2ft. ft., From... 2ft. ft. to 0ft. ft., From ft. to ft.
 What is the nearest source of possible contamination:
 1 Septic tank 4 Lateral lines 7 Pit privy 11 Fuel storage 14 Abandoned water well
 2 Sewer lines 5 Cess pool 8 Sewage lagoon 12 Fertilizer storage 15 Oil well/Gas well
 3 Watertight sewer lines 16 Seepage pit 9 Feedyard 13 Insecticide storage 16 Other (specify below)
 Direction from well? (NW) ~~of~~ How many feet? 75ft.

FROM	TO	LITHOLOGIC LOG	FROM	TO	PLUGGING INTERVALS
0.	.75	Gravel Road Base			
.75	2.50	Dk Brown silty (bavely) clay			
2.50	4.50	Blue silty mottled clay			
4.50	13.50	Blue-green silty sand w/ Dk Green to Black silty stringers, mucous, fine grained			
13.50	15.0	Tanish Brown silty sandy clay, iron oxide staining, mottled			

7 CONTRACTOR'S OR LANDOWNER'S CERTIFICATION: This water well was (1) constructed (2) reconstructed, or (3) plugged under my jurisdiction and was completed on (mo/day/year) 3-2-93 and this record is true to the best of my knowledge and belief. Kansas Water Well Contractor's License No. 539 This Water Well Record was completed on (mo/day/yr) 3-9-93 under the business name of JB Environmental Drilling by (signature) James Pieku