


WATER WELL RECORD Form WWC-5 KSA 82a-1212

1 LOCATION OF WATER WELL: County: Leavenworth Fraction: NW 1/4 NE 1/4 SW 1/4 Section Number: 24 Township Number: T 8 S Range Number: R 22 EW

Distance and direction from nearest town or city street address of well if located within city?
In Leavenworth

2 WATER WELL OWNER: Kaaz Const.
RR#, St. Address, Box #: 716 Cherokee
City, State, ZIP Code: Leavenworth, Ks.
Board of Agriculture, Division of Water Resources
Application Number:

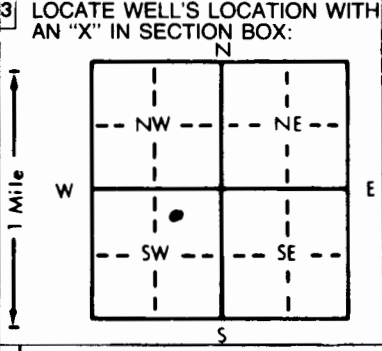

4 DEPTH OF COMPLETED WELL: 20ft ft. ELEVATION: ft.
Depth(s) Groundwater Encountered 1. 14' ft. 2. ft. 3. ft.
WELL'S STATIC WATER LEVEL: 14.6 ft. below land surface measured on mo/day/yr 3-3-93
Pump test data: Well water was ft. after hours pumping gpm
Est. Yield gpm: Well water was ft. after hours pumping gpm
Bore Hole Diameter: 6.58 in. to 20ft ft., and in. to ft.
WELL WATER TO BE USED AS:
5 Public water supply 8 Air conditioning 11 Injection well
1 Domestic 3 Feedlot 6 Oil field water supply 9 Dewatering 12 Other (Specify below)
2 Irrigation 4 Industrial 7 Lawn and garden only 10 Monitoring well
Was a chemical/bacteriological sample submitted to Department? Yes No X If yes, mo/day/yr sample was submitted
Water Well Disinfected? Yes No X

5 TYPE OF BLANK CASING USED:
1 Steel 3 RMP (SR) 5 Wrought iron 8 Concrete tile CASING JOINTS: Glued Clamped
2 PVC 4 ABS 6 Asbestos-Cement 9 Other (specify below) Welded
7 Fiberglass Threaded X
Blank casing diameter: 2.42 in. to 5ft ft., Dia in. to ft., Dia in. to ft.
Casing height above land surface: Flush Mount in., weight lbs./ft. Wall thickness or gauge No. Sdr-13 Sch 40
TYPE OF SCREEN OR PERFORATION MATERIAL:
1 Steel 3 Stainless steel 5 Fiberglass 8 RMP (SR) 10 Asbestos-cement 7 PVC 11 Other (specify)
2 Brass 4 Galvanized steel 6 Concrete tile 9 ABS 12 None used (open hole)
SCREEN OR PERFORATION OPENINGS ARE:
1 Continuous slot 3 Mill slot 5 Gauzed wrapped 8 Saw cut 11 None (open hole)
2 Louvered shutter 4 Key punched 6 Wire wrapped 9 Drilled holes
7 Torch cut 10 Other (specify)
SCREEN-PERFORATED INTERVALS: From 20ft ft. to 10ft ft., From ft. to ft.
GRAVEL PACK INTERVALS: From 20ft ft. to 9ft ft., From ft. to ft.
From ft. to ft., From ft. to ft.

6 GROUT MATERIAL: 1 Neat cement 2 Cement grout 3 Bentonite 4 Other
Grout intervals: From 9ft ft. to 2ft ft., From 2ft ft. to 0 ft., From ft. to ft.
What is the nearest source of possible contamination:
1 Septic tank 4 Lateral lines 7 Pit privy 10 Livestock pens 14 Abandoned water well
2 Sewer lines 5 Cess pool 8 Sewage lagoon 11 Fuel storage 15 Oil well/Gas well
3 Watertight sewer lines 6 Seepage pit 9 Feedyard 12 Fertilizer storage 16 Other (specify below)
13 Insecticide storage
Direction from well? North How many feet? 90ft

FROM	TO	LITHOLOGIC LOG	FROM	TO	PLUGGING INTERVALS
0	7.5	Asphalt w/ gravel base			
7.5	2.25	DK Brown-Black silty clay			
2.25	7.50	lt. Brown silty sandy clay w/ DK Brown thinly bedded silty stringers			
7.50	14.25	Green to Black sandy silt, fine grained			
14.25	15.50	Brown silty sandy clay, mottled			
15.50	20.0	DK Gray silty clay, mottled			

7 CONTRACTOR'S OR LANDOWNER'S CERTIFICATION: This water well was (1) constructed, (2) reconstructed, or (3) plugged under my jurisdiction and was completed on (mo/day/year) 3-3-93 and this record is true to the best of my knowledge and belief. Kansas Water Well Contractor's License No. 539 This Water Well Record was completed on (mo/day/yr) 3-9-93 under the business name of JB Environmental Drilling by (signature) James Bicker

OFFICE USE ONLY
T
R
EW
SEC
1/4
1/4
1/4