

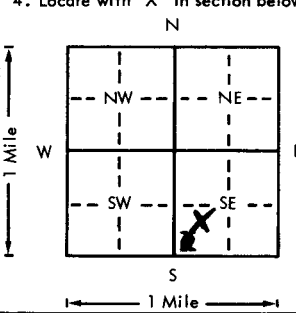
282

BRT R

USE TYPEWRITER OR BALL
POINT PEN-PRESS FIRMLY,
PRINT CLEARLY.

WATER WELL RECORD
KSA 82a-1201-1215

Kansas Department of Health and
Environment-Division of Environment
(Water well Contractors)
Topeka, Kansas 66620

1. Location of well:		County Leavenworth	Fraction SW 1/4 SW 1/4 SE 1/4	Section number 29	Township number T 8 S R 22E E/W	Range number
2. Distance and direction from nearest town or city: 2 mile west of Leavenworth Street address of well location if in city:				3. Owner of well: Jack Allen R.R. or street: 400 E. Eisenhower City, state, zip code: Lansing, Ks, 66043		
4. Locate with "X" in section below:		Sketch map:		6. Bore hole dia: 3 7/8 in. Completion date 7/20/79 Well depth 300 ft.		
				7. <input checked="" type="checkbox"/> Cable tool <input checked="" type="checkbox"/> Rotary <input type="checkbox"/> Driven <input type="checkbox"/> Dug <input type="checkbox"/> Hollow rod <input type="checkbox"/> Jetted <input type="checkbox"/> Bored <input type="checkbox"/> Reverse rotary		
5. Type and color of material		Well #1		8. Use: <input checked="" type="checkbox"/> Domestic <input type="checkbox"/> Public supply <input type="checkbox"/> Industry <input type="checkbox"/> Irrigation <input type="checkbox"/> Air conditioning <input type="checkbox"/> Stock <input type="checkbox"/> Lawn <input type="checkbox"/> Oil field water <input type="checkbox"/> Other		
clay (yellow)		0		9. Casing: Material <input type="checkbox"/> Height: Above or below		
shale and sandstone		23		Thread DRY HOLE Surface <input type="checkbox"/> in.		
shale (black)		70		RMP <input type="checkbox"/> PVC <input type="checkbox"/> Weight <input type="checkbox"/> lbs./ft.		
shale		75		Dia. <input type="checkbox"/> in. to <input type="checkbox"/> ft. depth Wall Thickness: inches or		
sandstone		81		Dia. <input type="checkbox"/> in. to <input type="checkbox"/> ft. depth gage No. <input type="checkbox"/>		
shale		97		10. Screens: Manufacturer's name DRY HOLE		
sandstone		135		Type <input type="checkbox"/> Dia. <input type="checkbox"/>		
shale		152		Slot/gauze <input type="checkbox"/> Length <input type="checkbox"/>		
limestone (lt, grey)		180		Set between <input type="checkbox"/> ft. and <input type="checkbox"/> ft.		
shale		192		<input type="checkbox"/> ft. and <input type="checkbox"/> ft.		
sandstone		220		Gravel pack? <input type="checkbox"/> Size range of material <input type="checkbox"/>		
shale (brwon)		235		11. Starting water level <input type="checkbox"/> mo./day/yr.		
limestone		249		<input type="checkbox"/> ft. below land surface Date <input type="checkbox"/>		
shale		262		12. Pumping level below land surfaces:		
shale (black)		293		<input type="checkbox"/> ft. after <input type="checkbox"/> hrs. pumping <input type="checkbox"/> g.p.m.		
				<input type="checkbox"/> ft. after <input type="checkbox"/> hrs. pumping <input type="checkbox"/> g.p.m.		
				Estimated maximum yield <input type="checkbox"/> g.p.m.		
				13. Water sample submitted: <input type="checkbox"/> mo./day/yr.		
				Yes DRY HOLE Date <input type="checkbox"/>		
				14. Well casing completion:		
				<input type="checkbox"/> Pitless adapter <input type="checkbox"/> Inches above grade		
				15. Well casing material:		
				<input type="checkbox"/> Neat cement <input type="checkbox"/> Bentonite <input type="checkbox"/> Concrete		
				Depth: From <input type="checkbox"/> ft. to <input type="checkbox"/> ft.		
				16. Nearest source of possible contamination:		
				ft. <input type="checkbox"/> Direction <input type="checkbox"/> Type <input type="checkbox"/>		
				Well disinfected upon completion? <input type="checkbox"/> Yes <input type="checkbox"/> No		
				17. Pump: <input type="checkbox"/> Not installed		
				Manufacturer's name <input type="checkbox"/>		
				Model number <input type="checkbox"/> HP <input type="checkbox"/> Volts <input type="checkbox"/>		
				Length of drop pipe <input type="checkbox"/> ft. capacity <input type="checkbox"/> g.p.m.		
				Type:		
				<input type="checkbox"/> Submersible <input type="checkbox"/> Turbine		
				<input type="checkbox"/> Jet <input type="checkbox"/> Reciprocating		
				<input type="checkbox"/> Centrifugal <input type="checkbox"/> Other		
18. Elevation: 920		19. Remarks: Customer is aware of state regulation and agrees to install a 4' square re-enforced concrete platform around top of well.		20. Water well contractor's certification:		
Topography: <input type="checkbox"/> Hill <input type="checkbox"/> Slope <input type="checkbox"/> Upland <input checked="" type="checkbox"/> Valley		X		This well was drilled under my jurisdiction and this report is true to the best of my knowledge and belief. F.E.Young Drilling Co., inc 240 Business name 8355 Robinhood Ln. License No. <input type="checkbox"/> Address David Young Date 8-2-79 Signed <input type="checkbox"/> Authorized representative		

Forward the white, blue and pink copies to the Department of Health and Environment

Form WWC-5

BR = 897