WATER WELL RECORD Form WWC-5 KSA 82a-1212

1 LOCATION OF WATER WELL: County: Leavenworth	Fraction: NW ¼ SW ¼ SE ¼	Section Number: 11	Township Number: T 8 S	Range Number: R 22 (E)/W

Distance and direction from nearest town or city street address of well if located within city?
821 McPherson Ave. (2000' S of MW5), FtLeavenworth

2 WATER WELL OWNER: USACE-DIS
RR#, St. Address, Box # : Attn: Rich Wilms 810 McClellan Ave.
City, State, ZIP Code : Ft. Leavenworth, KS 66027-8976

Board of Agriculture, Division of Water Resources
Application Number:

3 LOCATE WELL'S LOCATION WITH AN "X" IN SECTION BOX:

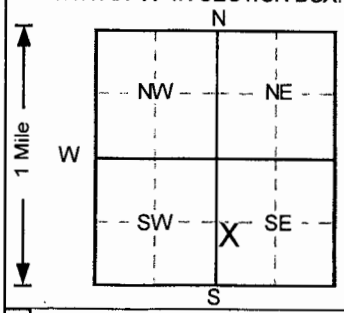

4 DEPTH OF COMPLETED WELL 43 ft. ELEVATION: 0
Depth(s) Groundwater Encountered 1. ... ft. 2. ... ft. 3. ... ft.
WELL'S STATIC WATER LEVEL 39.42 ft. below land surface measured on mo/day/yr 2/1/2005
Pump test data: Well water was NA ft. after ... hours pumping ... gpm
Est. Yield NA gpm: Well water was ... ft. after ... hours pumping ... gpm
Bore Hole Diameter 8 in. to 43 ft., and ... in. to ... ft.
WELL WATER TO BE USED AS: 5 Public water supply 8 Air conditioning 11 Injection well
1 Domestic 3 Feedlot 6 Oil field water supply 9 Dewatering 12 Other (Specify below)
2 Irrigation 4 Industrial 7 Lawn and garden only (10) Monitoring well
Was a chemical/bacteriological sample submitted to Department? Yes ... No ✓ ; If yes, mo/day/yr sample was submitted
Water Well Disinfected? Yes No ✓

5 TYPE OF BLANK CASING USED: 5 Wrought iron 8 Concrete tile CASING JOINTS: Glued ... Clamped ...
1 Steel 3 RMP (SR) 6 Asbestos-Cement 9 Other (specify below) Welded ...
(2) PVC 4 ABS 7 Fiberglass Threaded ✓
Blank casing diameter 2 in. to 33 ft., Dia ... in. to ... ft., Dia ... in. to ... ft.
Casing height above land surface 41 in., weight ... lbs./ft. Wall thickness or gauge No. Sch. 40
TYPE OF SCREEN OR PERFORATION MATERIAL (7) PVC 10 Asbestos-cement
1 Steel 3 Stainless steel 5 Fiberglass 8 RMP (SR) 11 Other (specify) ...
2 Brass 4 Galvanized steel 6 Concrete tile 9 ABS 12 None used (open hole)
SCREEN OR PERFORATION OPENINGS ARE: 5 Gauzed wrapped 8 Saw cut 11 None (open hole)
1 Continuous slot (3) Mill slot 6 Wire wrapped 9 Drilled holes
2 Louvered shutter 4 Key punched 7 Torch cut 10 Other (specify) ...
SCREEN-PERFORATED INTERVALS: From 33 ft. to 43 ft., From ... ft. to ... ft.
From ... ft. to ... ft., From ... ft. to ... ft.
GRAVEL PACK INTERVALS: From 31 ft. to 43 ft., From ... ft. to ... ft.
From ... ft. to ... ft., From ... ft. to ... ft.

6 GROUT MATERIAL: 1 Neat cement (2) Cement grout (3) Bentonite 4 Other ...
Grout Intervals: From 2 ft. to 29 ft., From 29 ft. to 31 ft., From ... ft. to ... ft.
What is the nearest source of possible contamination: 10 Livestock pens 14 Abandoned water well
1 Septic tank 4 Lateral lines 7 Pit privy 11 Fuel storage 15 Oil well/Gas well
2 Sewer lines 5 Cess pool 8 Sewage lagoon 12 Fertilizer storage 16 Other (specify below)
3 Watertight sewer lines 6 Seepage pit 9 Feedyard 13 Insecticide storage
Direction from well? How many feet?

FROM	TO	LITHOLOGIC LOG	FROM	TO	PLUGGING INTERVALS
0	38	Clay, silty, Brown			
38	43	Shale,			
					FTL07MW005 , Abovegrade
					Project Name: Arcadis - Ft. Leavenworth
					GeoCore # 1190 , #

7 CONTRACTOR'S OR LANDOWNER'S CERTIFICATION: This water well was (1) constructed, (2) reconstructed, or (3) plugged under my jurisdiction and was completed on (mo/day/year) 11/22/2004 and this record is true to the best of my knowledge and belief.
Kansas Water Well Contractor's License No. 527 This Water Well Record was completed on (mo/day/yr) 2/14/05
under the business name of GeoCore, Inc. by (signature) Dale Rolf

INSTRUCTIONS: Use typewriter or ball point pen. *PLEASE PRESS FIRMLY* and *PRINT* clearly. Please fill in blanks, underline or circle the correct answers. Send top three copies to Kansas Department of Health and Environment, Bureau of Water, Topeka, Kansas 66620-0001. Telephone: 913-296-5545. Send one to WATER WELL OWNER and retain one for your records.

OFFICE USE ONLY T R E/W SEC. ¼ ¼ ¼