


1	LOCATION OF WATER WELL: Fraction	Section Number	Township Number	Range Number
County:	Leavenworth SE 1/4 SW 1/4 NE 1/4	35	8	22-East

Distance and direction from nearest town or city street address of well if located within city?
788 Spruce Street, Leavenworth, Kansas

2	WATER WELL OWNER: Wood Oil Company	Board of Agriculture, Division of Water Resources
RR#, St. Address, Box #	P.O. Box 67	Application Number:
City, State, ZIP Code	Leavenworth, Kansas 66048	

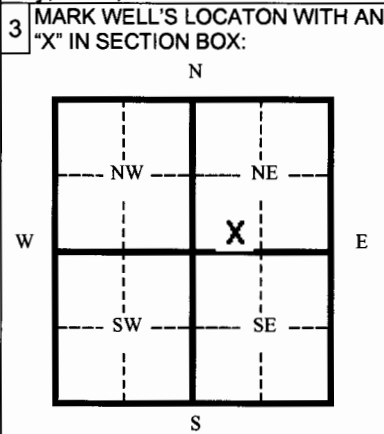

4	DEPTH OF WELL	15.0	ft.
	WELL'S STATIC WATER LEVEL	8.57	ft.
	WELL WAS USED AS:		
	1 Domestic	5 Public Water Supply	9 Dewatering
	2 Irrigation	6 Oil Field Water Supply	10 Monitoring Well
	3 Feedlot	7 Lawn and Garden (domestic)	11 Injection Well
	4 Industrial	8 Air Conditioning	12 Other
	Was a chemical/bacteriological sample submitted to Department?	Yes	No X
	If yes, mo/day/yr sample was submitted		
	Water Well Disinfected:	Yes	No X

5	TYPE OF BLANK CASING USED:	
	1 Steel	3 RMP (SR)
	2 PVC	4 ABC
	5 Wrought	7 Fiberglass
	6 Asbestos-Cement	8 Concrete Tile
	9 Other (specify below)	
	Blank casing diameter	2.375 in.
	Was casing pulled?	Yes X No
	If yes, how much?	15.0'
	Casing height above or below land surface	Unknown in.
		Well overdrilled to 15'

6	GROUT PLUG MATERIAL:	1 Neat cement	2 Cement grout	3 Bentonite	4 Other	Soils
	Grout Plug Intervals	From 15.0 ft. to 1.0 ft.	From 1.0 ft. to 0.0 ft.	From	ft. to	ft.
	What is the nearest source of possible contamination:					
	1 Septic tank	6 Seepage pit	11 Fuel storage	16 Other (specify below)		
	2 Sewer lines	7 Pit privy	12 Fertilizer storage			
	3 Watertight sewer lines	8 Sewage lagoon	13 Insecticide storage			
	4 Lateral lines	9 Feedyard	14 Abandoned water well			
	5 Cess Pool	10 Livestock pens	15 Oil well/ Gas well			
	Direction from well?	East	How many feet?	120		

FROM	TO	CODE	PLUGGING MATERIALS
0.0	1.0		Compacted soils
1.0	15.0		Bentonite chips

7	CONTRACTOR'S OR LANDOWNER'S CERTIFICATION: This water well was plugged under my jurisdiction and was completed on (mo/day/yr) 03/18/05 and this record is true to the best of my knowledge and belief. Kansas Water Well Contractor's License No. 692 This Water Well Record was completed on (mo/day/yr) 04/04/05 under the business name of Quad State Services, Inc. by (signature) <i>[Signature]</i>
---	---

INSTRUCTIONS: Please fill in blanks and circle the correct answers. Send three copies to Kansas Department of Health and Environment, Bureau of Water, 1000 S W Jackson St., Ste. 420, Topeka, Kansas 66620-0001. Telephone: 785-296-3565. Send one to Water Well Owner and retain one for your records.