


WATER WELL RECORD Form WWC-5 KSA 82a-1212

1 LOCATION OF WATER WELL: LEAVENWORTH
 County: LEAVENWORTH Fraction NW 1/4 SW 1/4 NW 1/4 Section Number 26 Township Number T 8 S Range Number R 22 EW

Distance and direction from nearest town or city street address of well if located within city?
 1100 METROPOLITAN AVENUE LEAVENWORTH, KS MW# 1

2 WATER WELL OWNER: SUZIE COLEMAN
 RR#, St. Address, Box #: 7215 S. TOPEKA BLVD
 City, State, ZIP Code: TOPEKA, KS 66619
 Board of Agriculture, Division of Water Resources
 Application Number:

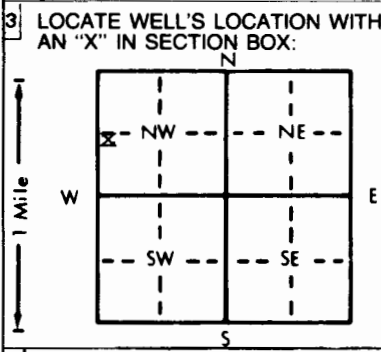

4 DEPTH OF COMPLETED WELL: 20 ft. ELEVATION:
 Depth(s) Groundwater Encountered 1. ft. 2. ft. 3. ft.
 WELL'S STATIC WATER LEVEL ft. below land surface measured on mo/day/yr
 Pump test data: Well water was ft. after hours pumping gpm
 Est. Yield gpm: Well water was ft. after hours pumping gpm
 Bore Hole Diameter: 7/4 in. to 20 ft., and in. to ft.
 WELL WATER TO BE USED AS:
 5 Public water supply 8 Air conditioning 11 Injection well
 1 Domestic 3 Feedlot 6 Oil field water supply 9 Dewatering 12 Other (Specify below)
 2 Irrigation 4 Industrial 7 Lawn and garden only 10 Monitoring well
 Was a chemical/bacteriological sample submitted to Department? Yes No; If yes, mo/day/yr sample was submitted
 Water Well Disinfected? Yes No

5 TYPE OF BLANK CASING USED:
 1 Steel 3 RMP (SR) 5 Wrought iron 8 Concrete tile CASING JOINTS: Glued Clamped
 2 PVC X 4 ABS 6 Asbestos-Cement 9 Other (specify below) Welded
 7 Fiberglass X Threaded
 Blank casing diameter in. to 10 ft., Dia in. to ft., Dia in. to ft.
 Casing height above land surface in., weight lbs./ft. Wall thickness or gauge No.
 TYPE OF SCREEN OR PERFORATION MATERIAL:
 1 Steel 3 Stainless steel 5 Fiberglass 8 RMP (SR) 10 Asbestos-cement
 2 Brass 4 Galvanized steel 6 Concrete tile 9 ABS 12 None used (open hole)
 SCREEN OR PERFORATION OPENINGS ARE:
 1 Continuous slot X3 Mill slot 0.10 5 Gauzed wrapped 8 Saw cut 11 None (open hole)
 2 Louvered shutter 4 Key punched 7 Torch cut 9 Drilled holes
 SCREEN-PERFORATED INTERVALS: From 20 ft. to 10 ft., From ft. to ft.
 GRAVEL PACK INTERVALS: From 20 ft. to 8 ft., From ft. to ft.

6 GROUT MATERIAL: 1 Neat cement X2 Cement grout 8 X3 Bentonite 64 Other
 Grout Intervals: From 6 ft. to -0.03 ft., From ft. to ft., From ft. to ft.
 What is the nearest source of possible contamination:
 1 Septic tank 4 Lateral lines 7 Pit privy X11 Fuel storage 14 Abandoned water well
 2 Sewer lines 5 Cess pool 8 Sewage lagoon 12 Fertilizer storage 15 Oil well/Gas well
 3 Watertight sewer lines 6 Seepage pit 9 Feedyard 13 Insecticide storage 16 Other (specify below)
 Direction from well? northeast How many feet? 18'

FROM	TO	LITHOLOGIC LOG	FROM	TO	PLUGGING INTERVALS
0	6"	ASPHALT			
6"	3	TOPSOIL			
3	10	BRN TO TAN SILTY CLAY			
10	18	TAN MOIST CLAY			
18	20	TAN WEATHERED CLAY			

7 CONTRACTOR'S OR LANDOWNER'S CERTIFICATION: This water well was (1) constructed, (2) reconstructed, or (3) plugged under my jurisdiction and was completed on (mo/day/year) 1-26-98 and this record is true to the best of my knowledge and belief. Kansas Water Well Contractor's License No. 575 This Water Well Record was completed on (mo/day/yr) 2-9-98 under the business name of KURTZ ENVIRONMENTAL SERVICE by (signature)

OFFICE USE ONLY
T
R
EW
SEC.
1/4
1/4
1/4