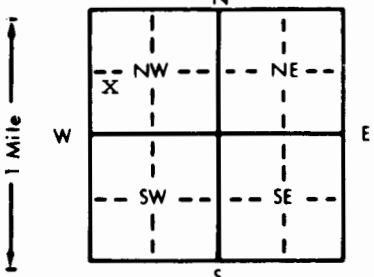


WATER WELL RECORD Form WWC-5 KSA 82a-1212

1 LOCATION OF WATER WELL: County: LEAVENWORTH	Fraction NW 1/4 SW 1/4 NW 1/4	Section Number 26	Township Number T 8 S	Range Number R 22 E
---	---	-----------------------------	---------------------------------	-------------------------------

Distance and direction from nearest town or city street address of well if located within city?
REAR SW CORNER OF 1109 11th ST. IN ALLEY LEAVENWORTH, KS MW#8


2 WATER WELL OWNER: **SUZIE COLEMAN**
 RR#, St. Address, Box # : **7215 S TOPEKA, BLVD** Board of Agriculture, Division of Water Resources
 City, State, ZIP Code : **TOPEKA, KS 66619** Application Number:

3 LOCATE WELL'S LOCATION WITH AN "X" IN SECTION BOX:

 4 DEPTH OF COMPLETED WELL: **20** ft. ELEVATION:
 Depth(s) Groundwater Encountered 1. ft. 2. ft. 3. ft.
 WELL'S STATIC WATER LEVEL ft. below land surface measured on mo/day/yr
 Pump test data: Well water was ft. after hours pumping gpm
 Est. Yield gpm: Well water was ft. after hours pumping gpm
 Bore Hole Diameter: **7 1/4** in. to **20** ft., and in. to ft.
 WELL WATER TO BE USED AS: 5 Public water supply 8 Air conditioning 11 Injection well
 1 Domestic 3 Feedlot 6 Oil field water supply 9 Dewatering 12 Other (Specify below)
 2 Irrigation 4 Industrial 7 Lawn and garden only **X** 10 Monitoring well
 Was a chemical/bacteriological sample submitted to Department? Yes No; If yes, mo/day/yr sample was sub-
 mitted Water Well Disinfected? Yes No

5 TYPE OF BLANK CASING USED:
 1 Steel 3 RMP (SR) 5 Wrought iron 8 Concrete tile CASING JOINTS: Glued Clamped
X 2 PVC 4 ABS 7 Fiberglass Welded
 Blank casing diameter in. to **10** ft., Dia in. to ft., Dia in. to ft.
 Casing height above land surface in., weight **sched 40** lbs./ft. Wall thickness or gauge No.
 TYPE OF SCREEN OR PERFORATION MATERIAL: **X** 7 PVC 10 Asbestos-cement
 1 Steel 3 Stainless steel 5 Fiberglass 8 RMP (SR) 11 Other (specify)
 2 Brass 4 Galvanized steel 6 Concrete tile 9 ABS 12 None used (open hole)
 SCREEN OR PERFORATION OPENINGS ARE:
 1 Continuous slot **X** 3 Mill slot **0.10** 5 Gauzed wrapped 8 Saw cut 11 None (open hole)
 2 Louvered shutter 4 Key punched **20** 6 Wire wrapped 9 Drilled holes
 7 Torch cut **10** 10 Other (specify)
 SCREEN-PERFORATED INTERVALS: From ft. to ft., From ft. to ft.
 From **20** ft. to **8** ft., From ft. to ft.
 GRAVEL PACK INTERVALS: From ft. to ft., From ft. to ft.

6 GROUT MATERIAL: 1 Neat cement **X** 2 Cement grout 8 **X** 3 Bentonite 6 4 Other
 Grout Intervals: From **6** ft. to **0.03** ft., From ft. to ft., From ft. to ft.
 What is the nearest source of possible contamination:
 1 Septic tank 4 Lateral lines 7 Pit privy 10 Livestock pens 14 Abandoned water well
 2 Sewer lines 5 Cess pool 8 Sewage lagoon 11 Fuel storage 15 Oil well/Gas well
X 3 Watertight sewer lines 6 Seepage pit 9 Feedyard 12 Fertilizer storage 16 Other (specify below)
 13 Insecticide storage
 Direction from well? **northeast** How many feet? **33'**

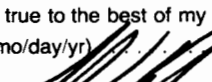FROM	TO	LITHOLOGIC LOG	FROM	TO	PLUGGING INTERVALS
0	8"	ASPHALT			
8"	2	BASE ROCK			
2	8	BRN SILTY CLAY			
8	14	BRN TO TAN CLAY			
14	18.5	MOIST TAN CLAY			
18.5	20	TAN WEATHERED SHALE TO LIMESTONE			
		@ 19.5			

7 CONTRACTOR'S OR LANDOWNER'S CERTIFICATION: This water well was (**X**) constructed, (2) reconstructed, or (3) plugged under my jurisdiction and was completed on (mo/day/year) **1-27-98** and this record is true to the best of my knowledge and belief. Kansas
 Water Well Contractor's License No. **575** This Water Well Record was completed on (mo/day/yr) **2-9-98**
 under the business name of **KURTZ ENVIRONMENTAL SERVICE** by (signature) 

OFFICE USE ONLY
T
R
EW
SEC
1/4
1/4
1/4