


MW-3

WATER WELL RECORD Form WWC-5 KSA 82a-1212

1 LOCATION OF WATER WELL: Fraction NE 1/4 NW 1/4 NE 1/4 Section Number 35 Township Number T 8 S Range Number R 22 EW
 County: LEAVENWORTH Distance and direction from nearest town or city street address of well if located within city? 201 S. Broadway

2 WATER WELL OWNER: KDTC Tom Winn Board of Agriculture, Division of Water Resources
 RR#, St. Address, Box #: Forbes Pkwy, Bldg 740 Application Number:
 City, State, ZIP Code: Topeka, KS 66602-0001

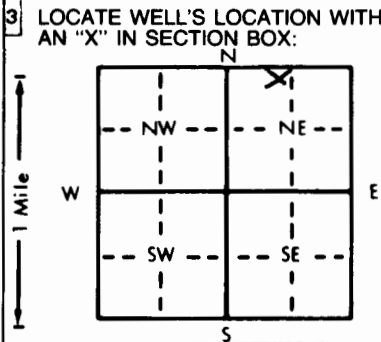

4 DEPTH OF COMPLETED WELL: 14 ft. ELEVATION: ---
 Depth(s) Groundwater Encountered: 1. 8.81 ft. 2. --- ft. 3. --- ft.
 WELL'S STATIC WATER LEVEL: 8.81 ft. below land surface measured on mo/day/yr 7/27/98
 Pump test data: Well water was --- ft. after --- hours pumping --- gpm
 Est. Yield --- gpm: Well water was --- ft. after --- hours pumping --- gpm
 Bore Hole Diameter: 8.625 in. to 14 ft., and --- in. to --- ft.
 WELL WATER TO BE USED AS:
 1 Domestic 3 Feedlot 6 Oil field water supply 9 Dewatering 12 Other (Specify below) MW-3
 2 Irrigation 4 Industrial 7 Lawn and garden only 10 Monitoring well
 Was a chemical/bacteriological sample submitted to Department? Yes No If yes, mo/day/yr sample was submitted ---
 Water Well Disinfected? Yes No

5 TYPE OF BLANK CASING USED:
 1 Steel 3 RMP (SR) 5 Wrought iron 8 Concrete tile CASING JOINTS: Glued Clamped
 2 PVC 4 ABS 6 Asbestos-Cement 9 Other (specify below) --- Welded
 7 Fiberglass Threaded
 Blank casing diameter: 2 in. to 4 ft., Dia. --- in. to --- ft., Dia. --- in. to --- ft.
 Casing height above land surface: 0 in., weight SCH 40 lbs./ft. Wall thickness or gauge No. ---
 TYPE OF SCREEN OR PERFORATION MATERIAL:
 1 Steel 3 Stainless steel 5 Fiberglass 8 RMP (SR) 10 Asbestos-cement
 2 Brass 4 Galvanized steel 6 Concrete tile 9 ABS 11 Other (specify) ---
 12 None used (open hole)
 SCREEN OR PERFORATION OPENINGS ARE:
 1 Continuous slot 3 Mill slot 5 Gauzed wrapped 8 Saw cut 11 None (open hole)
 2 Louvered shutter 4 Key punched 6 Wire wrapped 9 Drilled holes
 7 Torch cut 10 Other (specify) ---
 SCREEN-PERFORATED INTERVALS: From --- ft. to --- ft., From --- ft. to --- ft., From --- ft. to --- ft.
 SAND TRAVEL PACK INTERVALS: From --- ft. to --- ft., From --- ft. to --- ft., From --- ft. to --- ft.

6 GROUT MATERIAL: 1 Neat cement 2 Cement grout 3 Bentonite 4 Other
 Grout Intervals: 3 From 0 ft. to 4 ft., From --- ft. to --- ft., From --- ft. to --- ft.
 What is the nearest source of possible contamination:
 1 Septic tank 4 Lateral lines 7 Pit privy 10 Livestock pens 14 Abandoned water well
 2 Sewer lines 5 Cess pool 8 Sewage lagoon 11 Fuel storage 15 Oil well/Gas well
 3 Watertight sewer lines 6 Seepage pit 9 Feedyard 12 Fertilizer storage 13 Insecticide storage 16 Other (specify below) contaminated site

Direction from well?		LITHOLOGIC LOG		PLUGGING INTERVALS	
FROM	TO	FROM	TO	FROM	TO
0	5"		concrete		
5"	6"		Fill material, silty clay		
6"	14		Silty clay		
14	TD		end of borehole		

7 CONTRACTOR'S OR LANDOWNER'S CERTIFICATION: This water well was constructed, reconstructed, or plugged under my jurisdiction and was completed on (mo/day/year) 7/27/98 and this record is true to the best of my knowledge and belief. Kansas Water Well Contractor's License No. 685 This Water Well Record was completed on (mo/day/yr) --- under the business name of Accl by (signature) Adrian D. Deussen

OFFICE USE ONLY
T
R
EW
SEC.
1/4
1/4
1/4