


1 LOCATION OF WATER WELL: Fraction Section Number Township Number Range Number
 County: Leavenworth SE 1/4 SE 1/4 SW 1/4 36 8 22 EW

Distance and direction from nearest town or city street address of well if located within city?
4th + Maple Leavenworth

2 WATER WELL OWNER: ~~Raymond Ochs~~ Raymond Ochs
 RR #, St. Address, Box #: 1821 Rdge Rd Board of Agriculture, Division of Water Resources
 City, State, ZIP Code: Leavenworth KS Application Number:

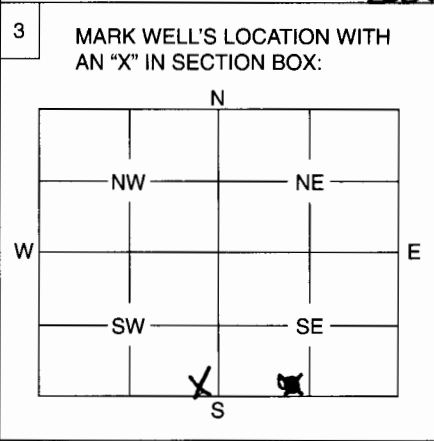

4 DEPTH OF WELL 30 ft.
 WELL'S STATIC WATER LEVEL 24 ft.
 WELL WAS USED AS:
 1 Domestic 2 Irrigation 3 Feedlot 4 Industrial 5 Public Water Supply 6 Oil Field Water Supply 7 Domestic (Lawn & Garden) 8 Air Conditioning 9 Dewatering 10 Monitoring Well 11 Injection Well 12 Other

Was a chemical / bacteriological sample submitted to Department? Yes No X.....
 If yes, mo/day/yr sample was submitted

Water Well Disinfected: Yes No X.....

5 TYPE OF BLANK CASING USED:
 1 Steel 2 PVC 3 RMP (SR) 4 ABS 5 Wrought 6 Asbestos-Cement 7 Fiberglass 8 Concrete Tile 9 Other (Specify below)

Blank casing diameter 2 in. Was casing pulled? Yes No X..... If yes, how much

Casing height above or below land surface 0 in.

6 GROUT PLUG MATERIAL: 1 Neat cement 2 Cement grout 3 Bentonite 4 Other soil

Grout Plug Intervals: From ft. to ft., From ft. to ft., From to ft.

What is the nearest source of possible contamination:
 1 Septic tank 2 Sewer lines 3 Watertight sewer lines 4 Lateral lines 5 Cess pool 6 Seepage pit 7 Pit privy 8 Sewage lagoon 9 Feedyard 10 Livestock pens 11 Fuel storage 12 Fertilizer storage 13 Insecticide storage 14 Abandoned water well 15 Oil well/Gas well 16 Other (specify below)

Direction from well? West north west How many feet? 120

FROM	TO	PLUGGING MATERIALS
<u>0</u>	<u>30</u>	<u>soil</u>

Well was previously destroyed

7 CONTRACTOR'S OF LANDOWNER'S CERTIFICATION: This water well was plugged under my jurisdiction and was completed on (mo/day/year) 5/1/06 and this record is true to the best of my knowledge and belief. Kansas Water Well Contractor's License No. 594 This Water Well Record was completed on (mo/day/year) 5/3/06 under the business name of Coranco Great Plains by (signature) Meghan E. Brown