

CORRECTION(S) TO WATER WELL RECORD (WWC-5)

(to rectify lacking or incorrect information)

County: Leavenworth

Location listed as:

Section-Township-Range: 35-52-22E

Fraction (  $\frac{1}{4}$   $\frac{1}{4}$   $\frac{1}{4}$ ): NW NE NE

Location changed to:

35-85-22E

NW NE NE

Other changes: Initial statements: \_\_\_\_\_

Changed to: \_\_\_\_\_

Comments: \_\_\_\_\_

verification method: Well address, city street map, and  
mapping tool on KGS website.

initials: DRB date: 12/20/2006


submitted by: Kansas Geological Survey, Data Resources Library, 1930 Constant Ave., Lawrence, KS 66047-3726  
to: Kansas Dept of Health & Environment, Bureau of Water, 1000 SW Jackson, Suite 420, Topeka, KS 66612-1367.

1 LOCATION OF WATER WELL: County: Leavenworth Fraction: NW 1/4 NE 1/4 NE 1/4 Section Number: 35 Township Number: E32 Range Number: 22  EW

Distance and direction from nearest town or city street address of well if located within city?

201 South Broadway, Leavenworth, KS

2 WATER WELL OWNER: Peliman Oil Global Positioning Systems (decimal degrees, min. of 4 digits)  
 RR#, St. Address, Box #: 201 S. Broadway Latitude: Unknown  
 City, State ZIP Code: Leavenworth, KS Longitude: Unknown  
 Elevation: 783.341  
 Datum: 783.601  
 Data Collection Method: Unknown

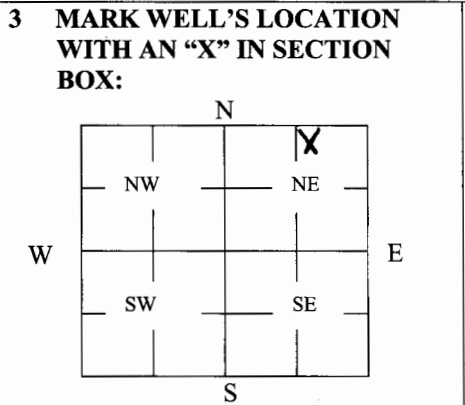

4 DEPTH OF WELL ~15 ft.  
 WELL'S STATIC WATER LEVEL 7.55 ft.  
 WELL WAS USED AS:  
 1 Domestic                      5 Public Water Supply                      9 Dewatering  
 2 Irrigation                      6 Oil Field Water Supply                       10 Monitoring  
 3 Feedlot                          7 Domestic (Lawn & Garden)                      11 Injection Well  
 4 Industrial                      8 Air Conditioning                          12 Other \_\_\_\_\_  
 Was a chemical/bacteriological sample submitted to Department? Yes \_\_\_\_\_ No

5 TYPE OF BLANK CASING USED:  
 1 Steel                      3 RMP (SR)                      5 Wrought                      7 Fiberglass                      9 Other (Specify below) \_\_\_\_\_  
 2 PVC                      4 ABS                          6 Asbestos-Cement                      8 Concrete Tile \_\_\_\_\_  
 Blank casing diameter 2 in. Was casing pulled? Yes  No \_\_\_\_\_ If yes, how much All  
 Casing height above or below land surface 0.27 feet

6 GROUT PLUG MATERIAL: 1 Neat cement                      2 Cement grout                       3 Bentonite                      4 Other \_\_\_\_\_  
 Grout Plug Intervals: From 15 ft. to 0.5 ft., From \_\_\_\_\_ ft. to \_\_\_\_\_ ft., From \_\_\_\_\_ to \_\_\_\_\_ ft.

What is the nearest source of possible contamination:  
 1 Septic tank                      6 Seepage pit                      11 Fuel Storage                       16 Other (specify below) former USTs  
 2 Sewer lines                      7 Pit privy                          12 Fertilizer storage  
 3 Watertight sewer lines                      8 Sewage lagoon                      13 Insecticide storage  
 4 Lateral lines                      9 Feedyard                          14 Abandoned water well                      Direction from well? South  
 5 Cess pool                          10 Livestock pens                      15 Oil well/Gas well                      How many feet? 50'

FROM	TO	PLUGGING MATERIALS	FROM	TO	PLUGGING MATERIALS
<u>0.5</u>	<u>15</u>	<u>Hydrated Bentonite Chips</u>			

7 CONTRACTOR'S OR LANDOWNER'S CERTIFICATION: This water well was plugged under my jurisdiction and was completed on (mo/day/year) 11/10/06 and this record is true to the best of my knowledge and belief. Kansas Water Well Contractor's License No. 704. This Water Well Record was completed on (mo/day/year) 11/29/06 under the business name of MAXS by (signature) David King

INSTRUCTIONS: Use typewriter or ballpoint pen. Please press firmly and print clearly. Please fill in blanks, underline or circle the correct answers. Send top three copies to Kansas Department of Health and Environment, Bureau of Water, Geology Section, 1000 SW Jackson St., Ste. 420, Topeka, Kansas 66612-1367. Telephone: 785/296-5522. Send one to Water Well Owner and retain one for your records. Visit us at <http://www.kdheks.gov/geo/waterwells>.